IREDELL COUNTY HEALTH DEPARTMENT

Statesville Phone TR 3-7271 Mooresville Phone NO 3-1271

PERMIT TO INSTALL SEPTIC TANK

Permit NO. _____ Permit Date 4-24- 1961

Owner U L Dearborn Address Olin Rt. 1

Installed By Clyde Hoke Address R 7


Location of Property left to right - right to turn around - next to last on right

| Tank | | Capacity | | Length of Lines | | Fixtures | |
|---|---|---|---|---|---|---|---|
| Block | ( ) | 800 | ( ) | 150' | ( ) | No. of Baths | ( 1 ) |
| Precast | (✓) | 900 | ( ) | 175' | ( ) | Dishwasher | ( ) |
| | | 1000 | (✓) | 200' | ( ) | Garbage Grdr. | ( ) |
| cast | | 1100 | ( ) | 225' | (✓) | Auto-Washer | ( ) |
| | | 1200 | ( ) | 250' | ( ) | Other | |
| | | Other | | Other | | | |

NOTIFY HEALTH DEPARTMENT AT LEAST EIGHT HOURS BEFORE TANK IS TO BE INSPECTED.

Final Inspection 4-24-1961 Approved (✓) Disapproved ( )

Remarks city water

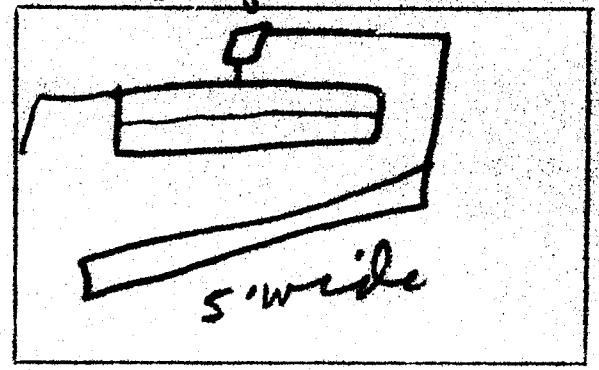


Sketch of Installation

Rat.

Sanitarian