IREDELL COUNTY HEALTH DEPARTMENT - *ENVIRONMENTAL HEALTH* ☑ STATESVILLE OFFICE 704-878-5305 ☐ MOORESVILLE OFFICE 704-664-5281

IMPROVEMENT PERMIT / AUTHORIZATION TO CONSTRUCT / OPERATION PERMIT / EXISTING SYSTEM INSPECTION

PERMIT # Repair PIN # 4743868002 DATE 10-29-12

OWNER Ginger Meadows APPLICANT: Same PHONE: Home/Cell # 704-873-5521 Business # N/A

SITE ADDRESS 137 Deal Ln. OWNER / APPLICANT ADDRESS 1716 Old Mountain Rd. Statesville

SITE DIRECTIONS Hwy 70 E TR Barkley Rd TR Deal Ln. Last house on left.

SUBDIVISION Glen Echo BLOCK / SECTION N/A LOT # 17 + 18 LOT AREA 0.55 DESIGN FLOW 360gpd L.T.A.R. 0.3

Septic Tank Existing Gallons: STB ____ Date ____

Pump Tank ____ Gallons: P T ____ Date ____

Pump Make ____ Model ____ Serial # ____

No. Nitrification Fields: 1 No. Lines 3 Linear Feet 300+

Trench Width 36" Max. Trench Bottom Depth 36"

☐ New System ☑ Repair ☐ Expansion System Type I II ☒ III IV V VI

System Description: ____

Repair System Description: 25% Reduction

Maintenance Agreement Required ☐ YES ☑ NO

Gravel Depth N/A ☑ GRAVITY ☐ PRESSURE

☑ Residence No. Bedrooms 3

☐ Business No. Persons ____

☐ Other No. Employees ____

☐ Slab ☐ Crawl Space


☑ Basement w/plumbing ☐ Basement w/o plumbing

Water Supply: ☐ Private ☑ Public ☐ Community


Comments / Conditions

- Install a 25% Reduction system on contour with serial distribution. Relocate existing water line so that it meets the minimum 10' setback to all components of septic system. Replace tank and/or tee if needed.

INITIAL SITE SKETCH

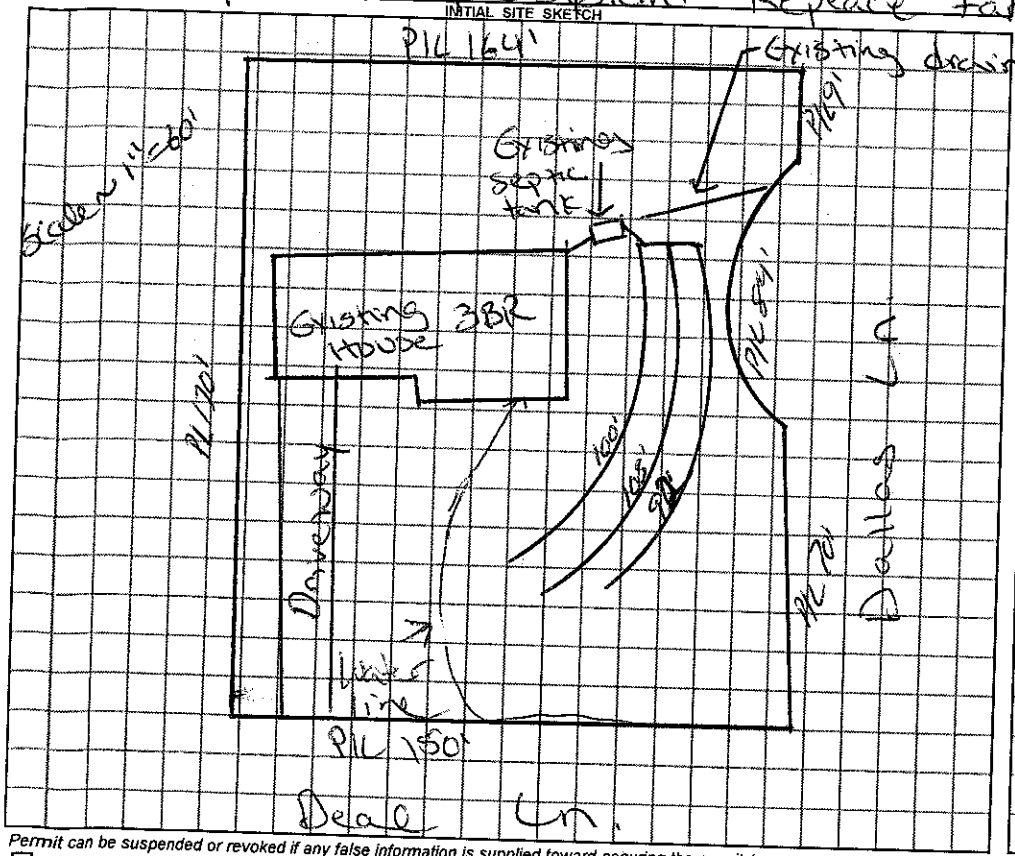

AS BUILT SKETCH

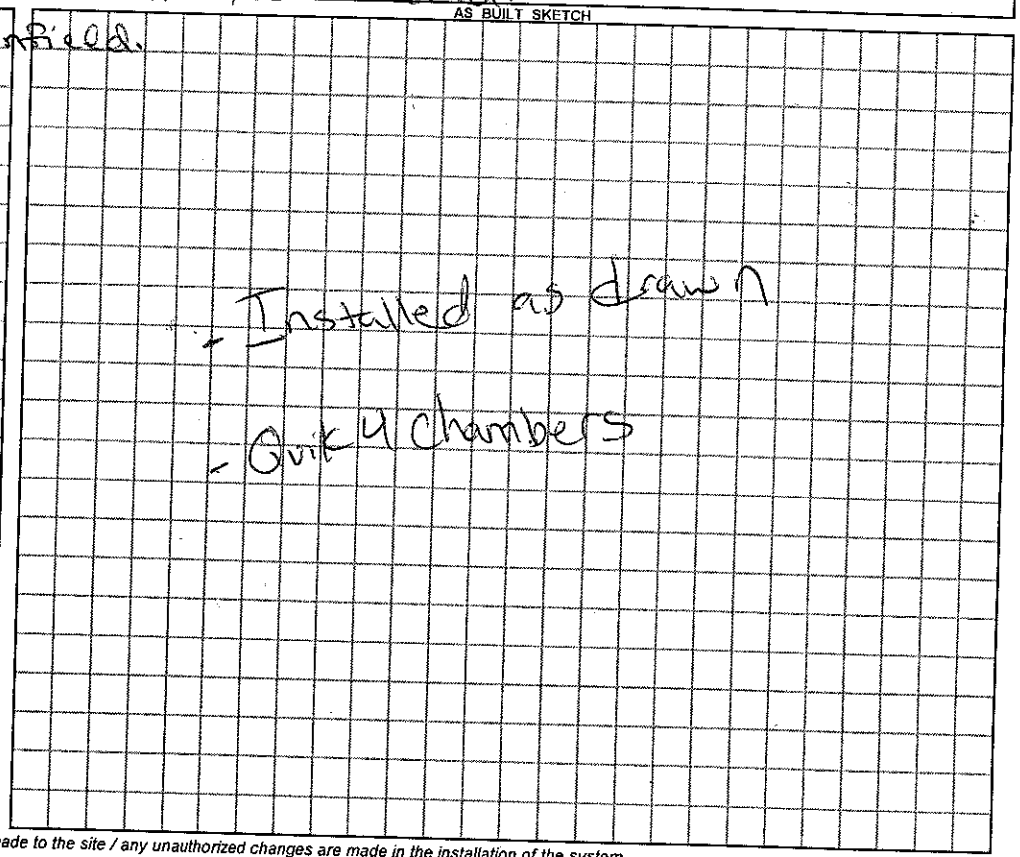

Permit can be suspended or revoked if any false information is supplied toward securing the permit / any unauthorized changes are made to the site / any unauthorized changes are made in the installation of the system.

☐ ***IMPROVEMENT PERMIT*** with plat valid without expiration. ☑ ***IMPROVEMENT PERMIT*** with ~~plat valid without expiration.~~ site plan valid 60 mo. ☐ ***AUTHORIZATION TO CONSTRUCT*** valid for period equal to IMPROVEMENT PERMIT--not to exceed 60 mo.

Owner / Applicant Signature: [signature] Date 10-29-12

IMPROVEMENT PERMIT by: Justin Henderson REHS Date 10-A-12

AUTHORIZATION TO CONSTRUCT by: Justin Henderson REHS Date 10-29-12

YOU SHOULD CONTACT A LOCATOR SERVICE PRIOR TO ANY EXCAVATION

Installed by: Kevin Bowles

OPERATION PERMIT by: Justin Henderson REHS Date 10-29-12

Existing System Inspected by: ____ REHS Date ____

White Copy – Environmental Health YELLOW COPY (Final) Owner / Applicant PINK COPY (Initial) Owner / Applicant