IREDELL COUNTY HEALTH DEPARTMENT

Statesville Phone TR 3-7271 Mooresville Phone NO 3-1271

PERMIT TO INSTALL SEPTIC TANK

Permit NO. _____ Permit Date 9-12 1964

Owner Sherrill Lumber Co. Address Glen Echo

Installed By C Hoke Address R2.


Location of Property 2nd on Rt 12 street to Rt

Tank		Capacity		Length of Lines		Fixtures	
Block	( )	800	( )	150'	( )	No. of Baths	(2)
Precast	(✓)	900	( )	175'	( )	Dishwasher	( )
		1000	(✓)	200'	( )	Garbage Grdr.	( )
Lash		1100	( )	225'	(✓)	Auto-Washer	(✓)
		1200	( )	250'	( )	Other	
		Other		Other			

NOTIFY HEALTH DEPARTMENT AT LEAST EIGHT HOURS BEFORE TANK IS TO BE INSPECTED.

Final Inspection 9-12-1964 Approved (✓) Disapproved ( )

Remarks City water Very Many Lot.

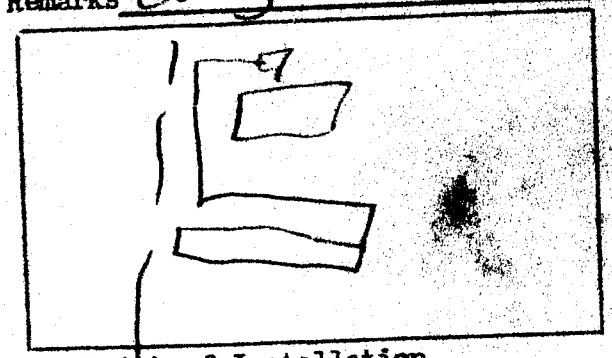

Sketch of Installation

R J Sherman

Sanitarian