2-5746

IREDELL COUNTY HEALTH DEPARTMENT

STATESVILLE 704-878-5305 MOORESVILLE 704-664-5281

IMPROVEMENT PERMIT / AUTHORIZATION TO CONSTRUCT / OPERATION PERMIT / EXISTING SYSTEM INSPECTION

PERMIT# REPAIR PIN# 4743-95-4880 DATE JUNE 30, 2004

OWNER OR CONTRACTOR PHILIP J. HRABAR PHONE: Business 704-880-3061 Home 704-873-7201

ADDRESS 115 ROBIN LANE STATESVILLE NC 28677

LOCATION US 70 EAST, TR BARKLEY ROAD (1ST), TR DEAD LANE, TL ROBIN LANE, 2ND HOUSE ON LEFT

SUBDIVISION GLEN ECHO BLOCK / SECTION ____ LOT 18 LOT AREA 0.53 ACRE SITE CLASS PS DESIGN FLOW 360 L.T.A.R. 0.3 GPD/FT²

Septic Tank: EXISTING Gallons; STB ____ Date ____

Pump Tank: ____ Gallons; PT ____ Date ____

Pump Make: ____ Model ____ Serial No. ____

Nitrification Field: No Fields 1 Square Feet EQ. 1" 400 Linear Feet 100

No Lines ONE Trench Width 36" Max Trench Bottom Depth ~36" +/- Gravel Depth N/A

☐ New System ☑ Repair System Type: I II III IV V VI

System Description: CONV. GRAVITY

Repair System Description: ~~EXPAND SYSTEM~~ 25% REDUCTION

Maintenance Agreement Required: ☐ Yes ☑ No

☑ House/Mod. Home No. Bedrooms 3

☐ Mobile Home No. Bathrooms ____

☐ Business No. Employees ____

☐ Other ____


☐ Slab ☑ Crawl Space ☐ Basement w/plumbing ☐ Basement wo/plumbing

Water Supply: ☐ Individual ☑ Public ☐ Community


Comments:/Conditions: ① INSTALL NEW DISTRIBUTION BOX AS SHALLOW AS POSSIBLE AS SHOWN ② INSTALL NEW 3'x100' DRAINLINE USING 25% REDUCTION SYSTEM (OR CONVENTIONAL W/18" STONE)

Comments:/Conditions: NEW SANITARY TEE INSTALLED IN SEPTIC TANK

INITIAL SITE SKETCH

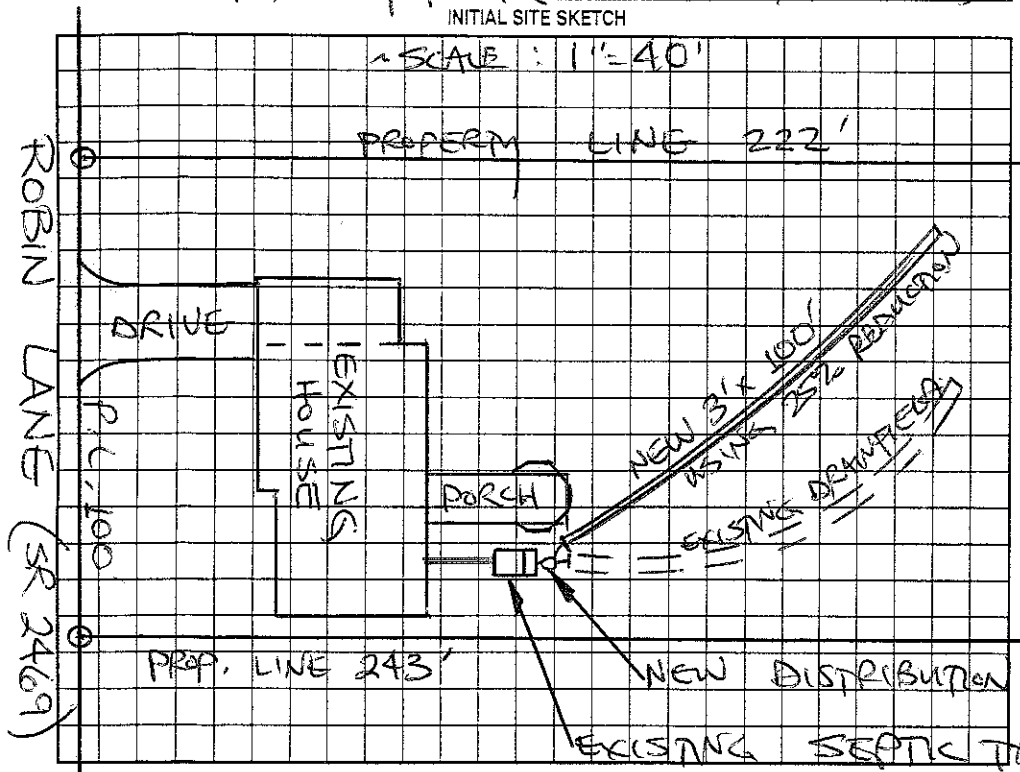

AS BUILT SKETCH

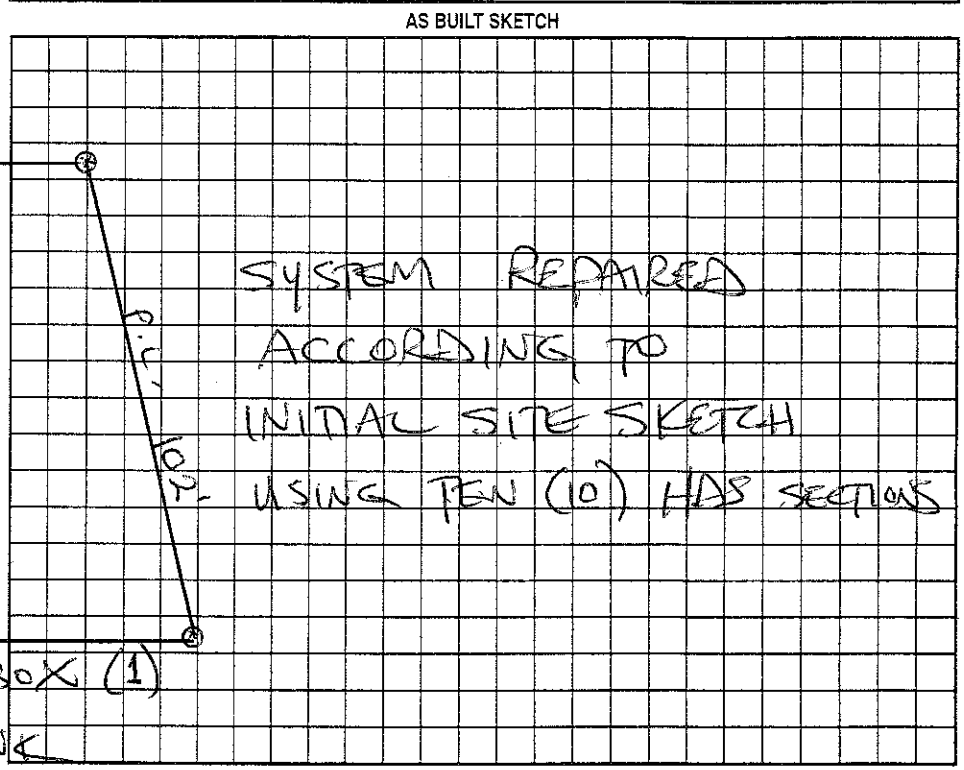

Permit can be suspended or revoked if any false information is supplied toward securing the permit/any unauthorized changes are made to the site/any unauthorized changes are made in the installation of the system. Improvement Permit with plat valid without expiration. Improvement Permit with site plan valid for sixty months. Authorization to Construct is valid for a period equal to that of Improvement Permit -- not to exceed sixty months.

Signed: Steve Hedrick date 6-30-04 Installed by: WES LYNTON

Improvement Permit by: STEVE HEDRICK date 6-30-04 Operation Permit by: STEVE HEDRICK date 7-30-04

Authorization to Construct by: STEVE HEDRICK date 6-30-04 Existing System Inspection by: ____ date ____

HEALTH DEPT. COPY: WHITE OWNER COPY (FINAL): YELLOW OWNER COPY (INITIAL): PINK