IREDELL COUNTY HEALTH DEPARTMENT

STATESVILLE 704-878-5305 MOORESVILLE 704-664-5281

IMPROVEMENT PERMIT / AUTHORIZATION TO CONSTRUCT / OPERATION PERMIT / EXISTING SYSTEM INSPECTION

PERMIT# Repair PIN# DATE 3-12-99

OWNER OR CONTRACTOR Doug Baity PHONE: Business Home 873-3727

ADDRESS 150 Barkley Rd Statesville

LOCATION 70 E TR Barkley Corner Barkley & Robin Ln

SUBDIVISION BLOCK / SECTION LOT LOT AREA SITE CLASS P/S DESIGN FLOW 360 L.T.A.R. 1

Septic Tank: 1000 Existing Gallons; STB Date

Pump Tank: Existing Gallons; PT Date

Pump Make: Model Serial No.

Nitrification Field: No Fields 2 Square Feet 600 Linear Feet 200

No Lines 4 Trench Width 36in Max Trench Bottom Depth 36in

☐ New System ☒ Repair System Type: I II III IV V VI

System Description:

Repair System Description: Gravity Conventional

Maintenance Agreement Required: ☐ Yes ☐ No Bed

☒ House/Mod. Home No. Bedrooms 3

☐ Mobile Home No. Bathrooms 2½

☐ Business No. Employees

☐ Other


☐ Slab ☐ Crawl Space ☒ Basement w/plumbing ☐ Basement wo/plumbing

Water Supply: ☐ Individual ☒ Public ☐ Community

Comments/Conditions: Pipe all gutters off of system
2 Beds ① 6x45ft ② 6x70ft 18in stone

Comments/Conditions

INITIAL SITE SKETCH

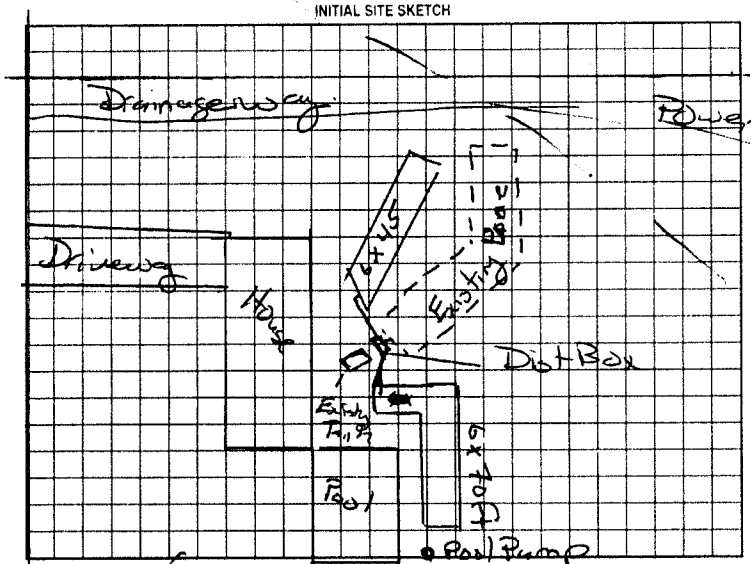

AS BUILT SKETCH

Same as initial sketch

Permit can be suspended or revoked if any false information is supplied toward securing the permit/any unauthorized changes are made to the site/any unauthorized changes are made in the installation of the system. Improvement Permit with plat valid without expiration. Improvement Permit with site plan valid for sixty months. Authorization to Construct is valid for a period equal to that of Improvement Permit - not to exceed sixty months.

Signed: Doug M Baity date

Improvement Permit by: Mary C Offerd date 3-12-99

Authorization to Construct by: Mary C Offerd date 3-12-99

Installed by: James Hutler

Operation Permit by: F. C. Moore date 4-21-99

Existing System Inspection by: date

HEALTH DEPT COPY WHITE OWNER COPY (FINAL) YELLOW OWNER COPY (INITIAL) PINK