IREDELL COUNTY HEALTH DEPARTMENT

(1) STATESVILLE 704-878-5305 (2) MOORESVILLE 704-664-5281

IMPROVEMENT PERMIT / AUTHORIZATION TO CONSTRUCT / OPERATION PERMIT / EXISTING SYSTEM INSPECTION

PERMIT# ~~123906~~ 125946 PIN# 4743-95-8316 7452 DATE 9-22-04

OWNER OR CONTRACTOR DONALD & DEBRA BLOOD PHONE: Business 704-872-0348 Home 704-873-3341

ADDRESS 135 ROBIN LANE STATESVILLE NC 28677

LOCATION US 70 EAST, TR N. BARKLEY ROAD TR E. BARKLEY ROAD, TR ROBIN LANE 1ST LOT ON RIGHT

SUBDIVISION GLEN ECHO BLOCK / SECTION ~~LOT~~ 12 13 LOT AREA SITE CLASS PS DESIGN FLOW 360 L.T.A.R. 0.40 GPD/FT²

Septic Tank: 1000 Gallons; STB 1007 Date 4-18-05
Pump Tank: Gallons; PT Date
Pump Make: Model Serial No. 225
Nitrification Field: No. Fields 1 Square Feet 900 Linear Feet ~~300~~
No Lines FOUR Trench Width 36" Max Trench Bottom Depth 36" Gravel Depth 12"

☑ New System ☐ Repair System Type: I II III IV V VI (100)
System Description: 25% REDUCTIONAL CONVENTIONAL, GRAVITY
Repair System Description: CONVENTIONAL, PUMP
Maintenance Agreement Required: ☐ Yes ☑ No


☑ House/Mod. Home No. Bedrooms 3
☐ Mobile Home No. Bathrooms
☐ Business No. Employees
☐ Other
☐ Slab ☑ Crawl Space ~~☐ Basement~~ ☑ Basement wo/plumbing

Water Supply: ☐ Individual ☑ Public ☐ Community

Comments:/Conditions: (3) LOT #11, 12, & 13 TO BE COMBINED INTO ONE SINGLE LOT PRIOR TO ISSUING BUILDING PERMIT
(2) KEEP SYSTEM MINIMUM 15' FROM BASEMENT FOUNDATION


Comments:/Conditions: SEPTIC TANK WITH MARKER INSTALLED USING "ZABEL" FILTER

INITIAL SITE SKETCH

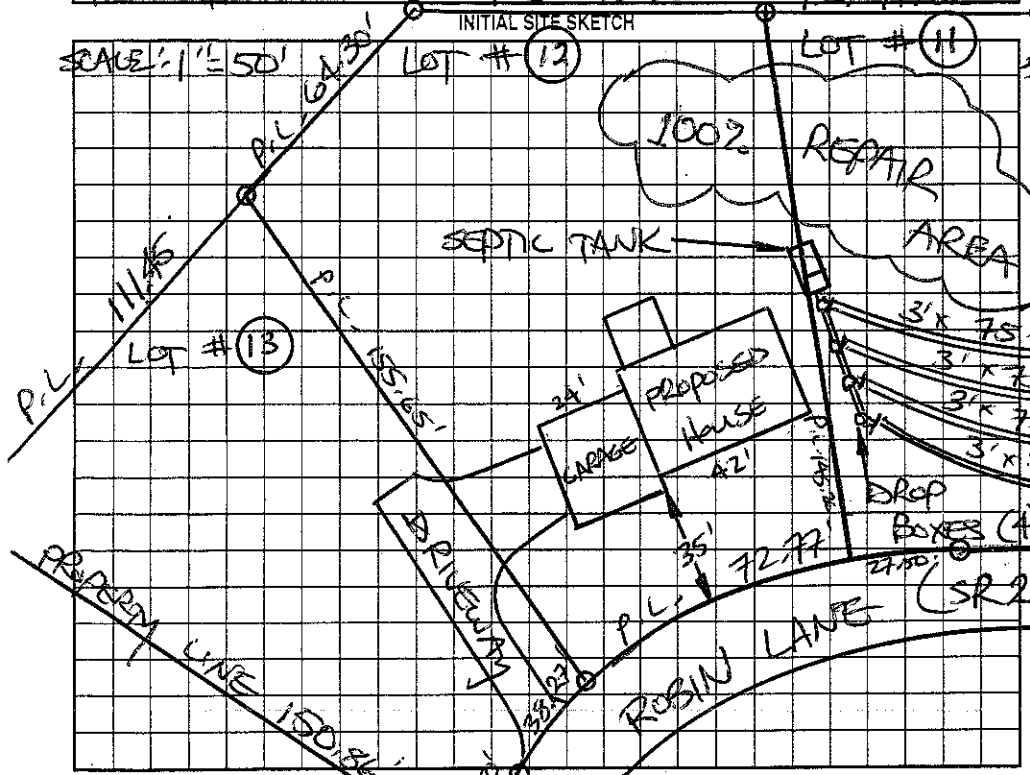

AS BUILT SKETCH

AN "ACCEPTED" SYSTEM WAS INSTALLED USING 56 "QUICK-FOUR INFILTRATOR" CHAMBERS

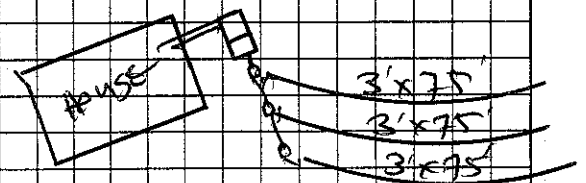

Permit can be suspended or revoked if any false information is supplied toward securing the permit/any unauthorized changes are made to the site/any unauthorized changes are made in the installation of the system. Improvement Permit with plat valid without expiration. Improvement Permit with site plan valid for sixty months. Authorization to Construct is valid for a period equal to that of Improvement Permit – not to exceed sixty months.

Signed: X Donna D. Feely date 9-22-04

Improvement Permit by: STEVE HEDRICK date 9-22-04

Authorization to Construct by: STEVE HEDRICK date 9-22-04

Installed by: A & C GRADING

Operation Permit by: STEVE HEDRICK date 6-8-05

Existing System Inspection by: date

HEALTH DEPT. COPY: WHITE OWNER COPY (FINAL): YELLOW OWNER COPY (INITIAL): PINK