IREDELL COUNTY HEALTH DEPARTMENT

STATESVILLE 704-878-5305 MOORESVILLE 704-664-5281

IMPROVEMENT PERMIT / AUTHORIZATION TO CONSTRUCT / OPERATION PERMIT / EXISTING SYSTEM INSPECTION

PERMIT# REPAIR PIN# 4743 96 1416 DATE 8-29-05

OWNER OR CONTRACTOR EDWARD KEVIN KIRK PHONE: Business 704-929-9465 Home 704-832-3733

ADDRESS 109 ROCKWOOD LANE STATESVILLE NC 28677

LOCATION US 70 EAST TR BARKLEY RD TR ROCKWOOD LANE 2ND HOUSE ON LEFT

SUBDIVISION GLEN ECHO BLOCK / SECTION ____ LOT 30 LOT AREA 0.48 ACRE SITE CLASS. PS! DESIGN FLOW 360 L.T.A.R. 0.30 GPD/FT²

Septic Tank: EXISTING Gallons; STB ____ Date ____

Pump Tank: ____ Gallons; PT ____ Date ____

Pump Make: ____ Model ____ Serial No. ____

Nitrification Field: No Fields 1 Square Feet 390 Linear Feet 130

No Lines TWO Trench Width 36" Max Trench Bottom Depth 36"

☐ New System ☑ Repair System Type: I, II, III, IV, V, VI

System Description: ____

Repair System Description: CONVENTIONAL, GRAVITY

Maintenance Agreement Required: ☐ Yes ☑ No

Gravel Depth 18"

☑ House/Mod. Home No. Bedrooms 3

☐ Mobile Home No. Bathrooms ____

☐ Business No. Employees ____

☐ Other ____


☐ Slab ☐ Crawl Space ☐ Basement w/plumbing ☐ Basement wo/plumbing

Water Supply:
☐ Individual
☑ Public
☐ Community

Comments:/Conditions: INTERCEPT EXISTING DRAINLINE AT LOCATION SHOWN WITH TWO NEW DROP BOXES FEEDING TWO NEW 3' x 65' DRAINLINES USING 18" STONE

Comments:/Conditions:

INITIAL SITE SKETCH

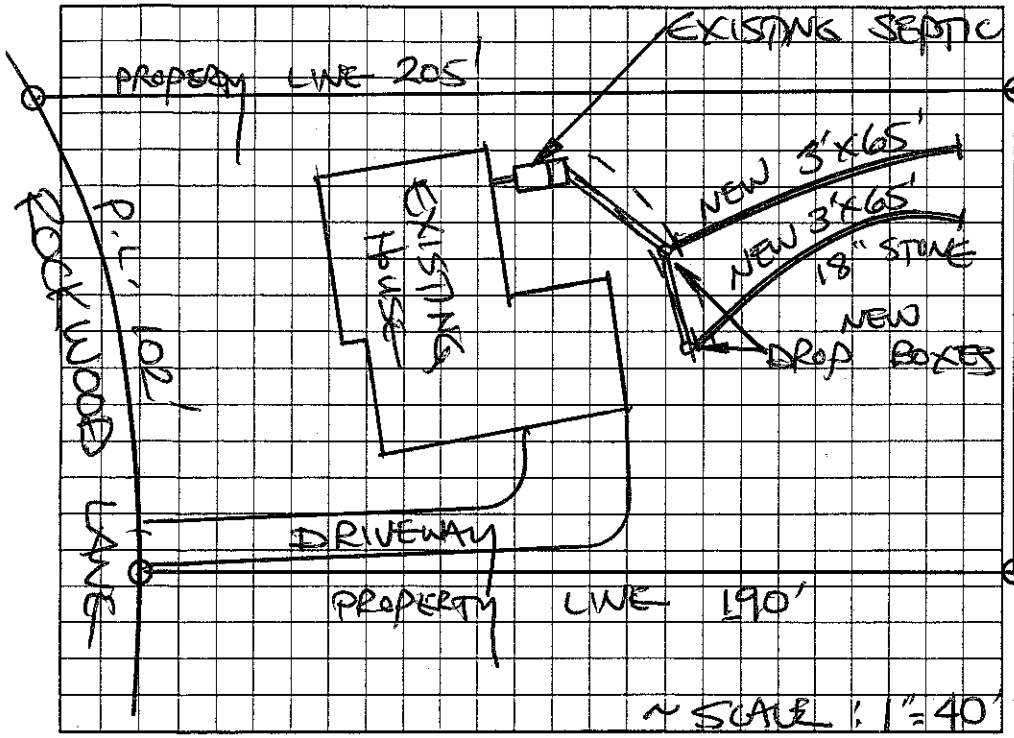

AS BUILT SKETCH

SYSTEM REPAIRED ACCORDING TO INITAL SITE SKETCH

Permit can be suspended or revoked if any false information is supplied toward securing the permit/any unauthorized changes are made to the site/any unauthorized changes are made in the installation of the system. Improvement Permit with plat valid without expiration. Improvement Permit with site plan valid for sixty months. Authorization to Construct is valid for a period equal to that of Improvement Permit - not to exceed sixty months.

Signed: Edward Kevin Kirk date 8/29/05 Installed by: PIEDMONT BACKHOE

Improvement Permit by: STEVE HENDRICK date 8-29-05 Operation Permit by: STEVE HENDRICK date 9-22-05

Authorization to Construct by: STEVE HENDRICK date 8-29-05 Existing System Inspection by: ____ date ____

HEALTH DEPT. COPY: WHITE OWNER COPY (FINAL): YELLOW OWNER COPY (INITIAL): PINK