IREDELL COUNTY HEALTH DEPARTMENT

Statesville Phone TR 3-7271 Mooresville Phone NO 3-1271

PERMIT TO INSTALL SEPTIC TANK

Permit NO._____ Permit Date 6-24-1960

Owner H. R. Barkley HYDE HOKE Address Glen Echo.

Installed By C Hoke Address R 7,


Location of Property 1st on left. Glen Echo.

Tank		Capacity		Length of Lines		Fixtures	
Block	( )	800	( )	150'	( )	No. of Baths	(7)
Precast	(✓)	900	( )	175'	( )	Dishwasher	( )
		1000	( )	200'	( )	Garbage Grdr.	( )
Wood		1100	( )	225'	(✓)	Auto-Washer	(✓)
		1200	( )	250'	( )	Other_____	
		Other_____		Other_____			

NOTIFY HEALTH DEPARTMENT AT LEAST EIGHT HOURS BEFORE TANK IS TO BE INSPECTED.

Final Inspection 6-24-1960 Approved ( ) Disapproved ( )

Remarks City Water -

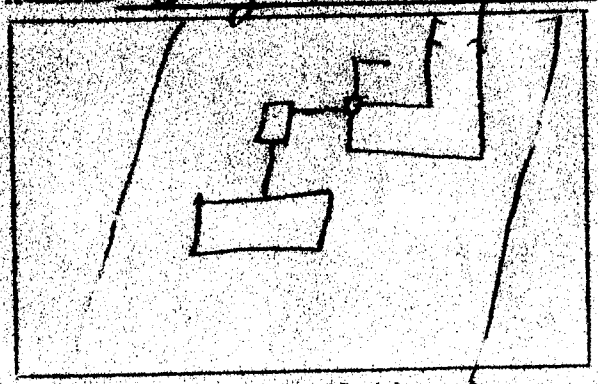

Sketch of Installation

R. L. Cooper.

Sanitarian