3:30

IREDELL COUNTY HEALTH DEPARTMENT

STATESVILLE 704-878-5305 MOORESVILLE 704-664-5281

IMPROVEMENT PERMIT / AUTHORIZATION TO CONSTRUCT / OPERATION PERMIT / EXISTING SYSTEM INSPECTION

PERMIT# REPAIR PIN# 4743-96-3220 DATE 11-28-06

OWNER OR APPLICANT WILLIAM G. PADGETT PHONE: Business 704-872-6209 Home 704-252-0658

ADDRESS 112 DEAL LANE, STATESVILLE, NC 28677

LOCATION US 70 WEST, TR BARKLEY ROAD, TR DEAL LANE, 2ND HOUSE ON RIGHT AT #112

SUBDIVISION GLEN ECHO BLOCK / SECTION ____ LOT 12 LOT AREA 0.34 ACRE SITE CLASS. PS DESIGN FLOW 360 L.T.A.R. 0.30 GPD/FT²

Septic Tank: EXISTING Gallons: STB ____ Date ____

Pump Tank: ____ Gallons: PT ____ Date ____

Pump Make: ____ Model ____ Serial No. ____

Nitrification Field: No Fields 1 Square Feet 336 TO Linear Feet 84

No Lines TWO Trench Width 36" Max Trench Bottom Depth 36"

☐ New System ☑ Repair ☐ Expansion System Type: I II III IV V VI

System Description: ____

Repair System Description: 25% REDUCTION

Maintenance Agreement Required: ☐ Yes ☑ No

Gravel Depth N/A ☑ Gravity ☐ Pressure

☑ House/Mod. Home No. Bedrooms 3

☐ Mobile Home No. Persons ____

☐ Business No. Employees ____

☐ Other ____


Water Supply: ☐ Individual ☑ Public ☐ Community

☐ Slab ☑ Crawl Space ☐ Basement w/plumbing ☐ Basement wo/plumbing


Comments/Conditions: ① INSTALL NEW DISTRIBUTION BOX AT SEPTIC TANK FEEDING OLD LINE FIRST. ② INSTALL NEW 25% REDUCTION SYSTEM AS SHOWN.

Comments/Conditions: ③ CHECK SEPTIC TANK FOR INTEGRITY REPLACE IF NECESSARY (W/ RISERS)

INITIAL SITE SKETCH ~SCALE: 1" = 30'

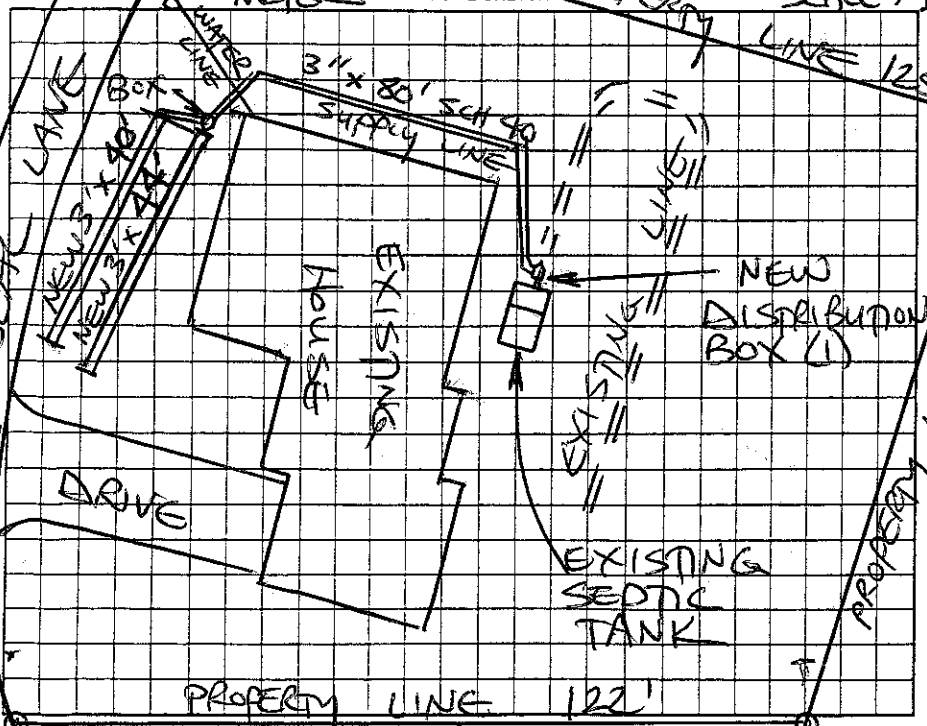

AS BUILT SKETCH

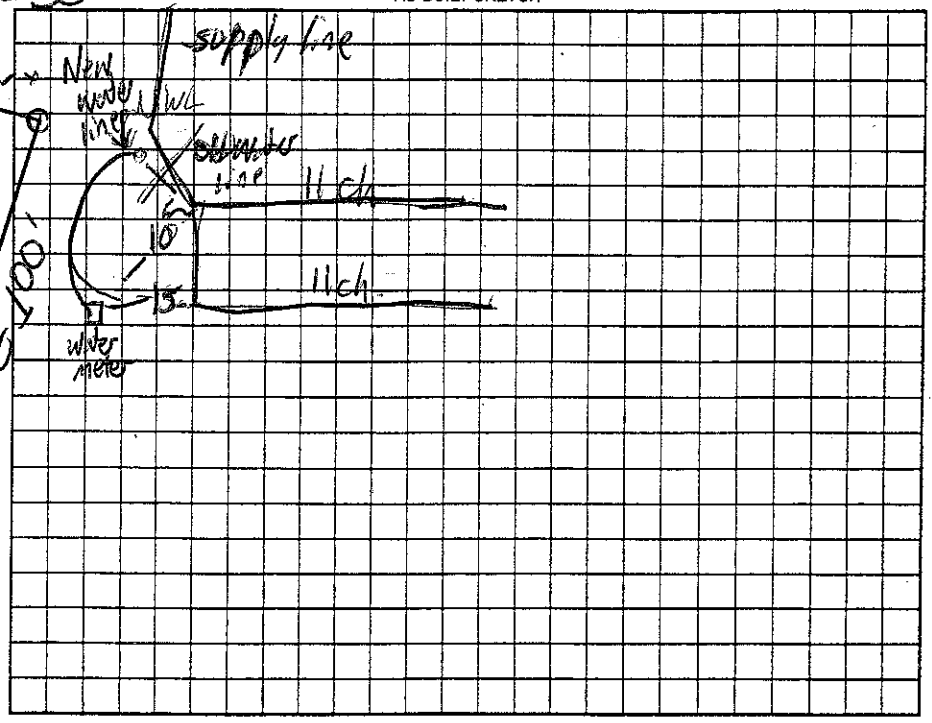

Permit can be suspended or revoked if any false information is supplied toward securing the permit/any unauthorized changes are made to the site/any unauthorized changes are made in the installation of the system. Improvement Permit with plat valid without expiration ☐ Improvement Permit with site plan valid for sixty months ☑ Authorization to Construct is valid for a period equal to that of Improvement Permit – not to exceed sixty months.

Signed: + Billy Padgett date 11/28/06 Installed by: Wes Lytton

Improvement Permit by: STEVE HENDRICK date 11-28-06 Operation Permit by: [signature] date 12-15-06

Authorization to Construct by: STEVE HENDRICK date 11-28-06 Existing System Inspection by: ____ date ____

HEALTH DEPT. COPY: WHITE OWNER COPY (FINAL): YELLOW OWNER COPY (INITIAL): PINK