IREDELL COUNTY HEALTH DEPARTMENT

Statesville Phone TR 3-7271 Mooresville Phone NO 3-1271

PERMIT TO INSTALL SEPTIC TANK

Permit No. 143 Permit Date 9-14 19 71

Owner Allen Crouch Address Statesville N.C.

Installed By Lackey Bro Address Stony Point


Location of Property Barkley Road - Straight across road from entrance into Glen Echo

Tank		Capacity		Length of Lines		Fixtures	
Block	( )	1000	(✓)	225'	( )	No. of Baths	(2)
Precast	(✓)	1250	( )	250'	( )	Dishwasher	(✓)
		1500	( )	Other 240'		Garbage Grdr.	( )
		Other				Other	

NOTIFY HEALTH DEPARTMENT AT LEAST EIGHT HOURS BEFORE TANK IS TO BE INSPECTED.

Final Inspection 9-14 19 71 Approved (✓) Disapproved ( )

Remarks City Water

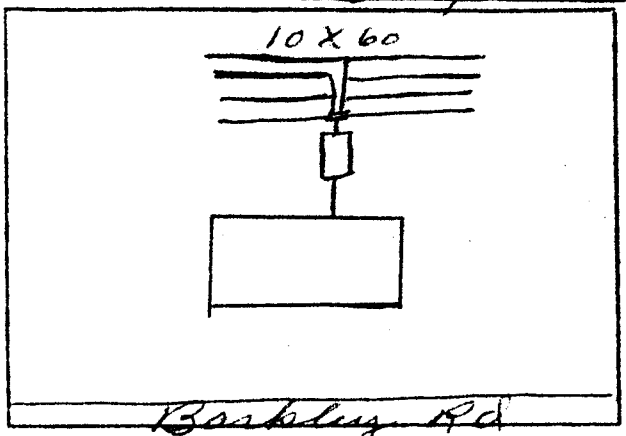

Sketch of Installation

E. A. Stevenson

Sanitarian