IREDELL COUNTY HEALTH DEPARTMENT

Statesville Phone TR 3-7271 Mooresville Phone NO 3-1271

PERMIT TO INSTALL SEPTIC TANK

Permit NO._____ Permit Date February 4, 1958

Owner Statesville Ice & Fuel Company Address Charlotte Hgwy, Statesville

Installed By Clyde Hoke Address Charlotte Hgwy, Statesville

Location of Property Out Charlotte Hgwy - across from Vance McLean's place,


White frame house.

Tank		Capacity		Length of Lines		Fixtures	
Block	( )	800	( )	150'	(✓)	No. of Baths	(1)
Precast	( )	900	( )	175'	( )	Dishwasher	( )
EXISTING		1000	(✓)	200'	( )	Garbage Grdr.	( )
		1100	( )	225'	( )	Auto-Washer	( )
		1200	( )	250'	( )	Other	
		Other		Other			

NOTIFY HEALTH DEPARTMENT AT LEAST EIGHT HOURS BEFORE TANK IS TO BE INSPECTED.

Final Inspection February 4th 1958 Approved (X) Disapproved ( )

Remarks Lines added as shown. Tuff-Lite used.

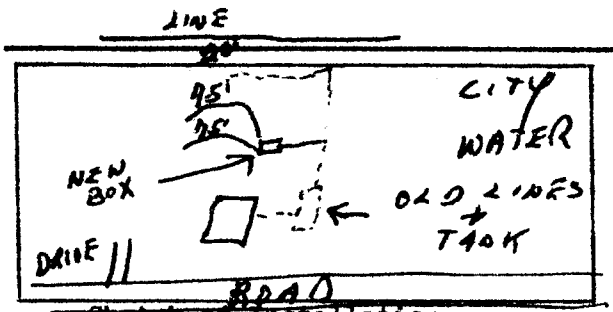

Sketch of Installation

Rayford A. Thomas

Sanitarian