IREDELL COUNTY HEALTH DEPARTMENT

Statesville Phone TR 3-7271 — Mooresville Phone NO 3-1271

PERMIT TO INSTALL SEPTIC TANK

Permit NO. _____ Permit Date Aug 17 1959

Owner Lee Kerns Address Davie Co.

Installed By Hoke Address _____


Location of Property Davie Co Shutt Rd TR 36257

Tank		Capacity		Length of Lines		Fixtures	
Block	( )	800	( )	150'	(✓)	No. of Baths	( )
Precast	(✓)	900	( )	175'	( )	Dishwasher	( )
		1000	( )	200'	( )	Garbage Grdr.	( )
		1100	( )	225'	( )	Auto-Washer	( )
		1200	( )	250'	( )	Other KITCHEN - ONLY	
		Other _____		Other _____			

NOTIFY HEALTH DEPARTMENT AT LEAST EIGHT HOURS BEFORE TANK IS TO BE INSPECTED.

Final Inspection Aug 17 1959 Approved (✓) Disapproved ( )

Remarks Kitchen sink only - owner advised to Mountain's tank against house

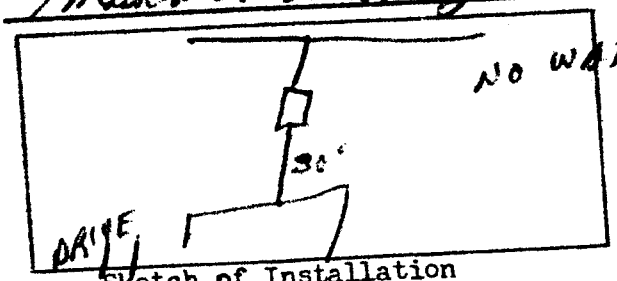

Sketch of Installation

Ralph G. Thomas
Sanitarian