IREDELL COUNTY HEALTH DEPARTMENT

Statesville Phone TR 3-7271 Mooresville Phone NO 3-1271

PERMIT TO INSTALL SEPTIC TANK

Permit No. _____ Permit Date 9-8 1964

Owner MR OLLIE Address 932 SHERWOOD DRIVE

Installed By SAM GAITHER Address _____


Location of Property 932 SHERWOOD DRIVE

Tank		Capacity		Length of Lines		Fixtures	
Block	( )	1000	(✓)	225'	(✓)	No. of Baths	( )
Precast	(✓)	1250	( )	250'	( )	Dishwasher	( )
		1500	( )	Other _____		Garbage Grdr.	( )
		Other _____				Other _____	

NOTIFY HEALTH DEPARTMENT AT LEAST EIGHT HOURS BEFORE TANK IS TO BE INSPECTED.

Final Inspection 9-8 1964 Approved (✓) Disapproved ( )

Remarks _____

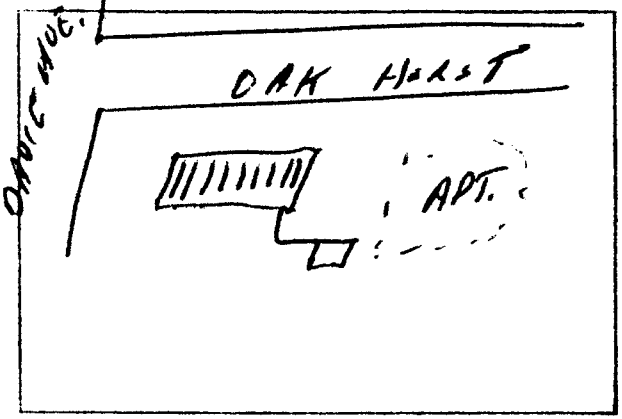

Sketch of Installation

APT ONLY

Raphael E Thomas R.S.

Sanitarian