IREDELL COUNTY HEALTH DEPARTMENT

STATESVILLE 704-878-5305 MOORESVILLE 704-664-5281

IMPROVEMENT PERMIT / AUTHORIZATION TO CONSTRUCT / OPERATION PERMIT / EXISTING SYSTEM INSPECTION

PERMIT# REPAIR PIN# 4744 60 4180 DATE 12-14-00

OWNER OR CONTRACTOR ANDRAE KNOX PHONE: Business Home 876-0741

ADDRESS 509 COVE GAP ROAD, STATESVILLE, NC 28625

LOCATION GARNER BAGNAL BLVD, TURN WALL ST, TL HOPE ST, TL HULL ST, AT END ON RIGHT

SUBDIVISION BLOCK / SECTION LOT LOT AREA SITE CLASS PS DESIGN FLOW 360 L.T.A.R. EXISTING

Septic Tank: EXISTING Gallons; STB Date

Pump Tank: Gallons; PT Date

Pump Make: Model Serial No.

Nitrification Field: No Fields 1 Square Feet 900 Linear Feet 280

No Lines THREE Trench Width 36" Max Trench Bottom Depth 36" Gravel Depth 24"

☐ New System ☑ Repair System Type: I (II) III IV V VI

System Description:

Repair System Description: CONVENTIONAL GRAVITY

Maintenance Agreement Required ☐ Yes ☐ No

☑ House/Mod. Home No. Bedrooms 3

☐ Mobile Home No. Bathrooms 1½

☐ Business No. Employees

☐ Other


☐ Slab ☑ Crawl Space ☐ Basement w/plumbing ☐ Basement wo/plumbing

Water Supply: ☐ Individual ☑ Public ☐ Community


Comments/Conditions: (1) THIS SYSTEM MUST BE REPAIRED WITHIN THIRTY (30) DAYS - BY 1-15-2001 (2) THIS PERMIT SERVES AS "NOTICE OF VIOLATION" (3) USE 24 INCHES STONE IN TRENCHES

Comments/Conditions: SYSTEM REPAIR ALTERED AS SHOWN BELOW WITH PRIOR HEALTH DEPTA APPROVAL TO AVOID EXISTING RES.

INITIAL SITE SKETCH

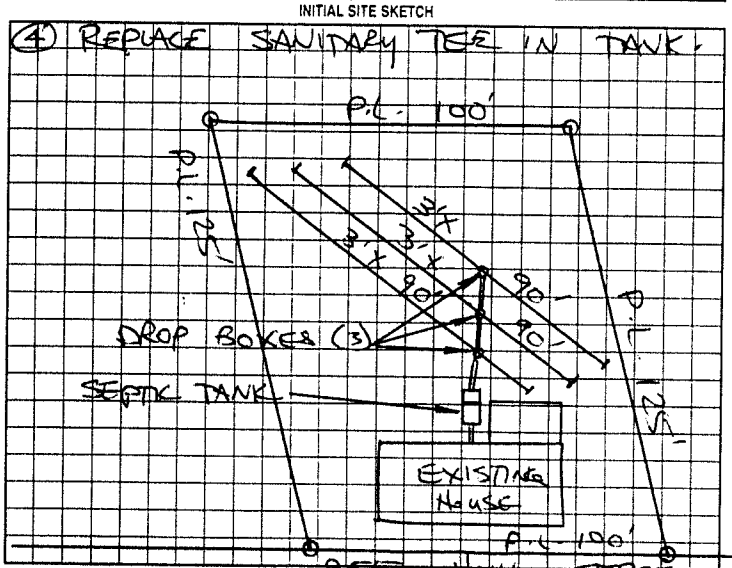

AS BUILT SKETCH

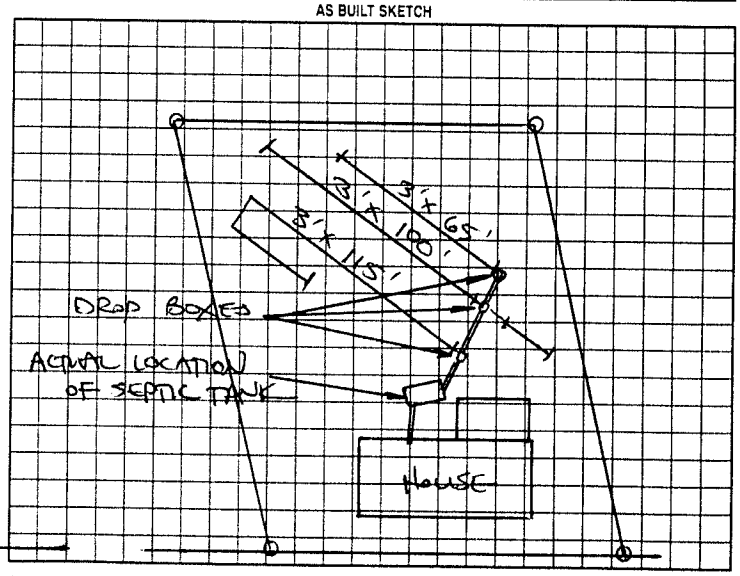

Permit can be suspended or revoked if any false information is supplied toward securing the permit/any unauthorized changes are made to the site/any unauthorized changes are made in the installation of the system. Improvement Permit with plat valid without expiration. Improvement Permit with site plan valid for sixty months. Authorization to Construct is valid for a period equal to that of Improvement Permit - not to exceed sixty months.

Signed: * Andrae S. Knox date 12-14-2000 Installed by: DALE FOX

Improvement Permit by: STEVE HEDRICK date 12-14-00 Operation Permit by: STEVE HEDRICK date 1-6-01

Authorization to Construct by: STEVE HEDRICK date 12-14-00 Existing System Inspection by: date

HEALTH DEPT COPY WHITE OWNER COPY (FINAL) YELLOW OWNER COPY (INITIAL) PINK