IREDELL COUNTY HEALTH DEPARTMENT

Statesville Phone TR 3-7271 Mooresville Phone NO 3-1271

PERMIT TO INSTALL SEPTIC TANK

Permit No. 112 Permit Date 6-7 1972

Owner R & S Builders Address Statesville, NC

Installed By Roy LENTZ Address Statesville, NC

Location of Property Hull ST

LOT No. 87-90


1st House on Rt

Tank		Capacity		Length of Lines		Fixtures	
Block	( )	1000	(✓)	225'	( )	No. of Baths	(1½)
Precast	(✓)	1250	( )	250'	( )	Dishwasher	( )
		1500	( )	Other 300		Garbage Grdr.	( )
		Other		900 by 4'		Other	

NOTIFY HEALTH DEPARTMENT AT LEAST EIGHT HOURS BEFORE TANK IS TO BE INSPECTED.

Final Inspection 6-7 1972 Approved (✓) Disapproved ( )

Remarks

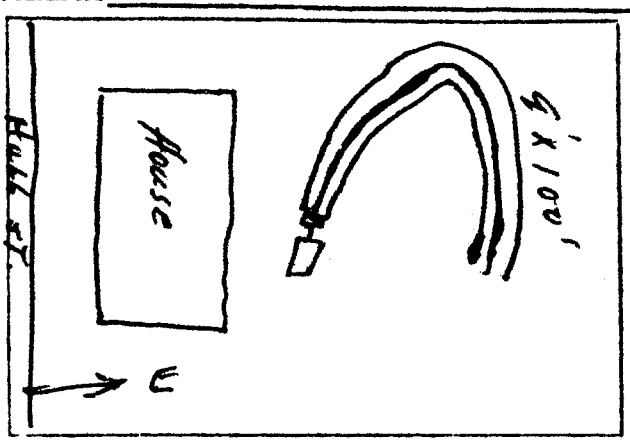

Sketch of Installation

Sanitarian