IREDELL COUNTY HEALTH DEPARTMENT

Statesville Phone TR 3-7271

Mooresville Phone NO 3-1271

Permit NO. _____

PERMIT TO INSTALL SEPTIC TANK

Permit Date June 23 1959

Owner Sippard Address Fox Ave

Installed By CLYDE HOKE Address

Location of Property last on Right on Fox Ave.


Tank		Capacity		Length of Lines		Fixtures	
Block	( )	800	(1)	150'	(1)	No. of Baths	(1)
Precast	(1)	900	( )	175'	( )	Dishwasher	( )
		1000	( )	200'	( )	Garbage Grdr.	( )
		1100	( )	225'	( )	Auto-Washer	( )
		1200	( )	250'	( )	Other	( )
		Other		Other			

NOTIFY HEALTH DEPARTMENT AT LEAST EIGHT HOURS BEFORE TANK IS TO BE INSPECTED.

Final Inspection June 23 1959

Approved ( ) Disapproved ( )

Remarks Self aqua - city water not for Washer

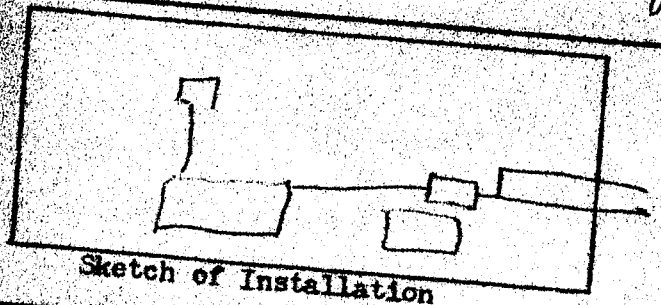

Sketch of Installation

R. G. T.

Sanitarian