IREDELL COUNTY HEALTH DEPARTMENT

Statesville Phone TR 3-7271 Mooresville Phone NO 3-1271

PERMIT TO INSTALL SEPTIC TANK

Permit NO._____ Permit Date June 1960

Owner Paul Barnes Address _____

Installed By Norwalk Vault Co. Address Troutman, N.C.


Location of Property Cynthia Street Statesville, N.C.

Tank		Capacity		Length of Lines		Fixtures	
Block	(✓)	800	( )	150'	( )	No. of Baths	( )
Precast	( )	900	( )	175'	( )	Dishwasher	( )
		1000	(✓)	200'	( )	Garbage Grdr.	( )
		1100	( )	225'	(✓)	Auto-Washer	( )
		1200	( )	250'	( )	Other _____	
		Other _____		Other _____			

NOTIFY HEALTH DEPARTMENT AT LEAST EIGHT HOURS BEFORE TANK IS TO BE INSPECTED.

Final Inspection _____ 195__ Approved ( ) Disapproved ( )

Remarks Paul Barnes Contractor

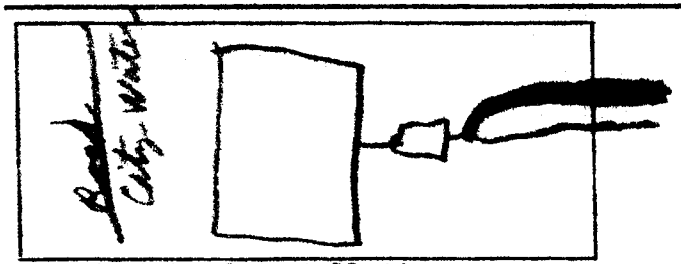

Sketch of Installation

Self approved
June
R. 9. 2.

(1)

Sanitarian