IREDELL COUNTY HEALTH DEPARTMENT

Statesville Phone TR 3-7271 Mooresville Phone NO 3-1271

PERMIT TO INSTALL SEPTIC TANK

Permit No. 102 Permit Date _____ 19__

Owner R. Brawley & B. Daniels Address Statesville, N.C.

Installed By Lackey Brothers Address Stony Point, N.C.


Location of Property Salisbury Rd to East Side Drive. 1st street left behind Unity School. House at end of Street on right

Tank		Capacity		Length of Lines		Fixtures	
Block	( )	1000	(✓)	225'	( )	No. of Baths	(✓)
Precast	( )	1250	( )	250'	( )	Dishwasher	( )
		1500	( )	Other _____		Garbage Grdr.	( )
		Other _____				Other _____	

NOTIFY HEALTH DEPARTMENT AT LEAST EIGHT HOURS BEFORE TANK IS TO BE INSPECTED.

Final Inspection 12-30-1970 Approved (✓) Disapproved ( )

Remarks _____

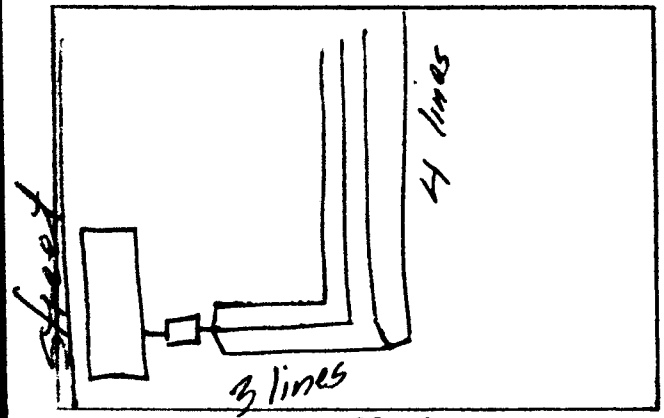

Sketch of Installation

Sanitarian