IREDELL COUNTY HEALTH DEPARTMENT

Statesville Phone TR 3-7271 Mooresville Phone No. 664-5281

PERMIT TO INSTALL SEPTIC TANK

Permit No. 721 Permit Date 6-28 1973

Owner BREWER - (John Lewis Trotter NCNC) Address 510 E. Side Drive

Installed By Sam Ostwalt Address Trantman, NC.


Location of Property 510 E. Side Dr.

Tank	Capacity	Length of Lines	Fixtures
Block ( )	1000 ( )	225' ( )	No. of Baths ( )
Precast (Repair)	1250 ( )	250' ( )	Dishwasher ( )
	1500 ( )	Other 150	Garbage Grdr. ( )
	Other		Other

NOTIFY HEALTH DEPARTMENT AT LEAST EIGHT HOURS BEFORE TANK IS TO BE INSPECTED.

Final Inspection 6-28 1973 Approved (✓) Disapproved ( )

Remarks

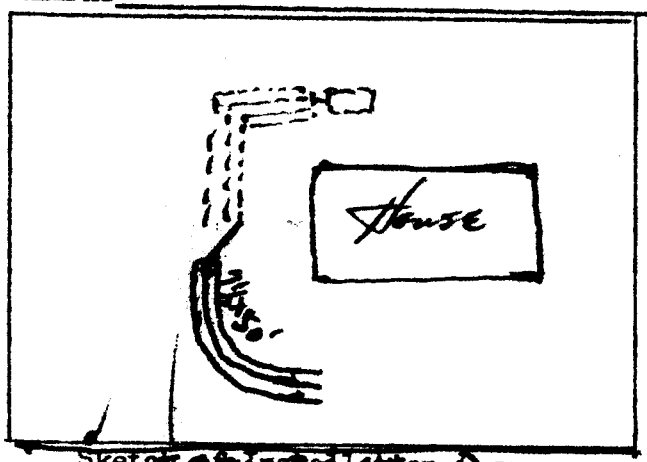

Sketch of Installation

Sanitarian