IREDELL COUNTY HEALTH DEPARTMENT

Statesville Phone TR 3-7271 Mooresville Phone NO 3-1271

PERMIT TO INSTALL SEPTIC TANK

Permit No. 131 (Bill Dishmon) Permit Date 6-16 19 72

Owner Hope Bros Bldrs Inc. Address Statesville, NC

Installed By Hope Bros. Address Statesville, NC

Location of Property

508 East Side Dr.


2nd House on Left past Rd. # 2408

Tank		Capacity		Length of Lines		Fixtures	
Block	( )	1000	(✓)	225'	(✓)	No. of Baths	(1)
Precast	(✓)	1250	( )	250'	( )	Dishwasher	( )
		1500	( )	Other		Garbage Grdr.	( )
		Other				Other	

NOTIFY HEALTH DEPARTMENT AT LEAST EIGHT HOURS BEFORE TANK IS TO BE INSPECTED.

Final Inspection 6-16 19 72 Approved (✓) Disapproved ( )

Remarks City of Sta. Water Supply

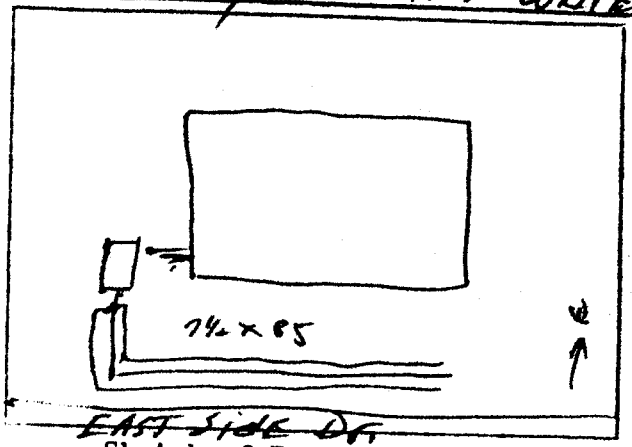

Sketch of Installation

Sanitarian