IREDELL COUNTY HEALTH DEPARTMENT

Statesville Phone TR 3-7271 — Mooresville Phone NO 3-1271

PERMIT TO INSTALL SEPTIC TANK

Permit NO. _____ Permit Date 5-25 1959

Owner Blackwelder & Threatt Address East side Dr.

Installed By C Hoke Address R7


Location of Property 1st new brick on left off Salisbury rd, about 1 mile. Corner lot before church

Tank		Capacity		Length of Lines		Fixtures	
Block	( )	800	(✓)	150'	( )	No. of Baths	(1)
Precast	(✓)	900	( )	175'	( )	Dishwasher	( )
		1000	( )	200'	( )	Garbage Grdr.	( )
		1100	( )	225'	(✓)	Auto-Washer	(✓)
		1200	( )	250'	( )	Other	
		Other		Other			

NOTIFY HEALTH DEPARTMENT AT LEAST EIGHT HOURS BEFORE TANK IS TO BE INSPECTED.

Final Inspection 5 2 5 1959 Approved ( ) Disapproved ( )

Remarks Self app for T&H. City water

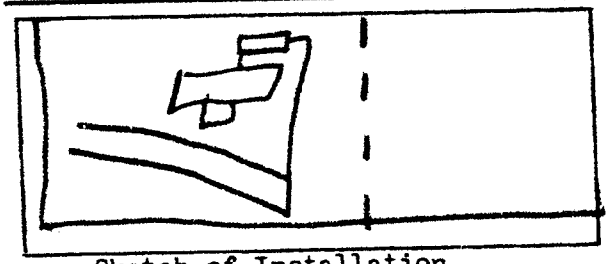

Sketch of Installation

RLZ

Sanitarian