IREDELL COUNTY HEALTH DEPARTMENT

Statesville Phone TR 3-7271 Mooresville Phone NO 3-1271

PERMIT TO INSTALL SEPTIC TANK

Permit No. _____ Permit Date June 9 1969

Owner Interstate Equipment Co Address PO Box 868-city

Installed By C Hoke & Sons Address R7


Location of Property Salisbury Rd.

Tank	Capacity	Length of Lines	Fixtures
Block ( )	1000 ( )	225' ( )	No. of Baths ( )
Precast (X)	1250 ( )	250' ( )	Dishwasher ( )
	1500 ( )	Other 1100 sq ft	Garbage Grdr. ( )
	Other _____		Other _____

NOTIFY HEALTH DEPARTMENT AT LEAST EIGHT HOURS BEFORE TANK IS TO BE INSPECTED.

Final Inspection _____ 19___ Approved (✓) Disapproved ( )

Remarks Repair to septic lines

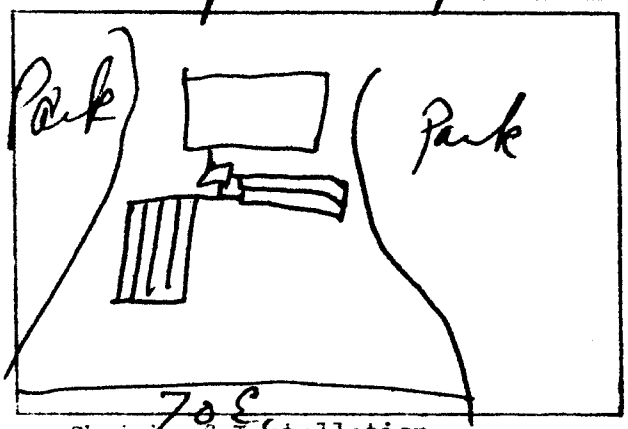

Sketch of Installation

R. M. Johnson RS I

Sanitarian