IREDELL COUNTY HEALTH DEPARTMENT

Statesville Phone TR 3-7271 — Mooresville Phone NO 3-1271

PERMIT TO INSTALL SEPTIC TANK

Permit NO._____ Permit Date May 7 1965

Owner Dalton Address R 7

Installed By C Hoke Address R 7


Location of Property across from Gordon junk yard.

Tank		Capacity		Length of Lines		Fixtures	
Block	( )	800	( )	150'	( )	No. of Baths	(1)
Precast	(+)	900	( )	175'	( )	Dishwasher	( )
		1000	(+)	200'	( )	Garbage Grdr.	( )
		1100	( )	225'	(+)	Auto-Washer	( )
		1200	( )	250'	( )	Other_____	
		Other_____		Other_____			

NOTIFY HEALTH DEPARTMENT AT LEAST EIGHT HOURS BEFORE TANK IS TO BE INSPECTED.

Final Inspection _____ 19___ Approved ( ) Disapproved ( )

Remarks city water - (over.)

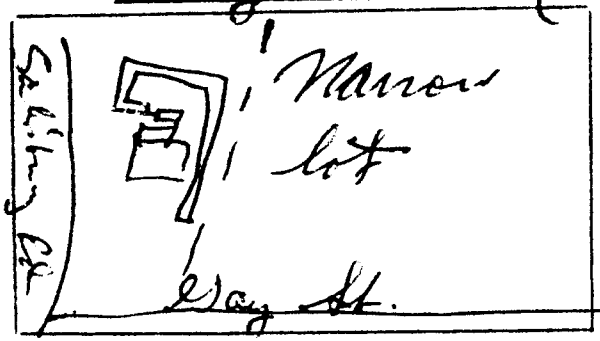

Sketch of Installation

Sanitarian