IREDELL COUNTY HEALTH DEPARTMENT

Statesville Phone TR 3-7271 Mooresville Phone NO 3-1271

PERMIT TO INSTALL SEPTIC TANK

Permit NO. _____ Permit Date 12-23-59 195__

Owner C Tittle caben Address Belmont

Installed By CLYDE HOKE Address _____

Location of Property Village in Belmont


Tank		Capacity		Length of Lines		Fixtures	
Block	(4)	800	( )	150'	(4)	No. of Baths	( )
Precast	( )	900	( )	175'	( )	Dishwasher	( )
		1000	( )	200'	( )	Garbage Grdr.	( )
Tittle		1100	( )	225'	( )	Auto-Washer	( )
Blde		1200	( )	250'	( )	Other	
		Other		Other			

NOTIFY HEALTH DEPARTMENT AT LEAST EIGHT HOURS BEFORE TANK IS TO BE INSPECTED.

Final Inspection 12-23-59 195__ Approved ( ) Disapproved ( )

Remarks #1 Na water 4 gpm well - 50'

bin one - 4 gpm

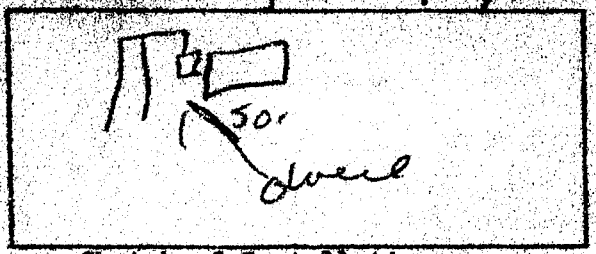

Sketch of Installation

Rt

Sanitarian