IREDELL COUNTY HEALTH DEPARTMENT

Statesville Phone TR 3-7271 Mooresville Phone NO 3-1271

PERMIT TO INSTALL SEPTIC TANK

Permit NO. _____ Permit Date Nov 3 1964

Owner W. H. Payne Address Belmont-Rt 6

Installed By C Hoke Address _____

Location of Property right off Salis. Rd. at fork 4 Rd. on left beyond Cement Sheet metal.


Tank		Capacity		Length of Lines		Fixtures	
Block	( )	800	( )	150'	( )	No. of Baths	(1)
Precast	(✓)	900	( )	175'	( )	Dishwasher	( )
		1000	(✓)	200'	( )	Garbage Grdr.	( )
		1100	( )	225'	(✓)	Auto-Washer	( )
		1200	( )	250'	( )	Other	_____
		Other	_____	Other	_____		

NOTIFY HEALTH DEPARTMENT AT LEAST EIGHT HOURS BEFORE TANK IS TO BE INSPECTED.

Final Inspection 11-3 1964 Approved (✓) Disapproved ( )

Remarks #4 last on left. city water

State Plumbing

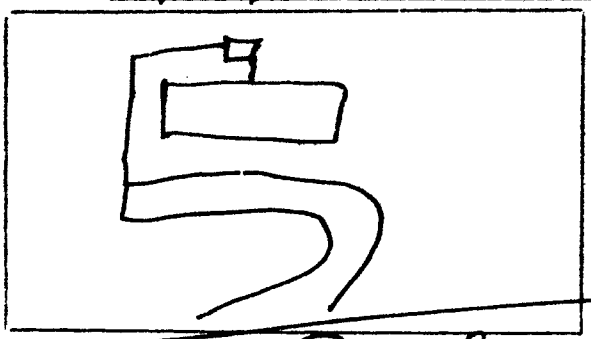

~~Sketch of Installation~~ Signed

Sanitarian