IREDELL COUNTY HEALTH DEPARTMENT

Statesville Phone TR 3-7271 Mooresville Phone NO 3-1271

PERMIT TO INSTALL SEPTIC TANK

Permit NO. _____ Permit Date 12-23-59 195_

Owner C L Little - CLYDE HOKE Address Belmont Com

Installed By _____ Address _____


Location of Property Village in Belmont

Tank		Capacity		Length of Lines		Fixtures	
Block	(✓)	800	( )	150'	(✓)	No. of Baths	( )
Precast	( )	900	( )	175'	( )	Dishwasher	( )
Little		1000	( )	200'	( )	Garbage Grdr.	( )
Elder		1100	( )	225'	( )	Auto-Washer	( )
		1200	( )	250'	( )	Other	
		Other		Other			

NOTIFY HEALTH DEPARTMENT AT LEAST EIGHT HOURS BEFORE TANK IS TO BE INSPECTED.

Final Inspection _____ 195_ Approved ( ) Disapproved ( )

Remarks #5 central water supply - lines only No Work

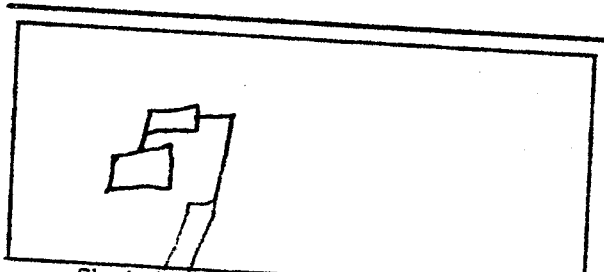

Sketch of Installation

Rut

Sanitarian