IREDELL COUNTY HEALTH DEPARTMENT

Statesville Phone TR 3-7271 — Mooresville Phone NO 3-1271

PERMIT TO INSTALL SEPTIC TANK

Permit NO. _____ Permit Date 12-17-59 195__

Owner C F Little builder asbergs Address Belmont c...

Installed By CLYDE HOKE Address _____


Location of Property Village in Belmont

Tank		Capacity		Length of Lines		Fixtures	
Block	(4)	800	( )	150'	(4)	No. of Baths	( )
Precast	( )	900	( )	175'	( )	Dishwasher	( )
Little		1000	( )	200'	( )	Garbage Grdr.	( )
Bldr		1100	( )	225'	( )	Auto-Washer	( )
		1200	( )	250'	( )	Other	
		Other		Other			

NOTIFY HEALTH DEPARTMENT AT LEAST EIGHT HOURS BEFORE TANK IS TO BE INSPECTED.

Final Inspection _____ 195__ Approved ( ) Disapproved ( )

Remarks #10 - Central water supply not for Washline lines only - Self appl.

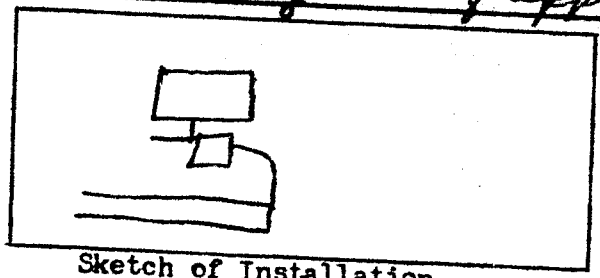

Sketch of Installation

Rut

Sanitarian