IREDELL COUNTY HEALTH DEPARTMENT

Statesville Phone TR 3-7271 — Mooresville Phone NO 3-1271

PERMIT TO INSTALL SEPTIC TANK

Permit NO. _____ Permit Date 12-17-59 195__

Owner C Little - asbestos Address Belmont Com

Installed By ~~CLYDE HOKE~~ Address _____


Location of Property Village in Belmont

Tank		Capacity		Length of Lines		Fixtures	
Block	(X)	800	( )	150'	(X)	No. of Baths	( )
Precast	( )	900	( )	175'	( )	Dishwasher	( )
		1000	( )	200'	( )	Garbage Grdr.	( )
Little		1100	( )	225'	( )	Auto-Washer	( )
Elder		1200	( )	250'	( )	Other _____	
		Other _____		Other _____			

NOTIFY HEALTH DEPARTMENT AT LEAST EIGHT HOURS BEFORE TANK IS TO BE INSPECTED.

Final Inspection 12-17-59 195__ Approved ( ) Disapproved ( )

Remarks #9-Central water supply not for washer - Selfseal lines only

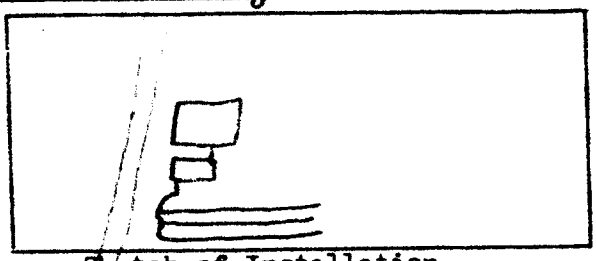

Sketch of Installation

Sanitarian