IREDELL COUNTY HEALTH DEPARTMENT

Statesville Phone TR 3-7271 Mooresville Phone NO 3-1271

PERMIT TO INSTALL SEPTIC TANK

Permit NO._____ Permit Date 12-29-59 195__

Owner C F Little Elder Auben Address Belmont Con.

Installed By CLYDE HOKE Address_____

Location of Property Village in Belmont


Tank		Capacity		Length of Lines		Fixtures	
Block	(+)	800	( )	150'	(+)	No. of Baths	( )
Precast	( )	900	( )	175'	( )	Dishwasher	( )
Little		1000	( )	200'	( )	Garbage Grdr.	( )
		1100	( )	225'	( )	Auto-Washer	( )
Elder		1200	( )	250'	( )	Other_____	
		Other_____		Other_____			

NOTIFY HEALTH DEPARTMENT AT LEAST EIGHT HOURS BEFORE TANK IS TO BE INSPECTED.

Final Inspection 12 - 29 - 1959 Approved ( ) Disapproved ( )

Remarks lines only - Belfast - Mowaka Central water supply

#11

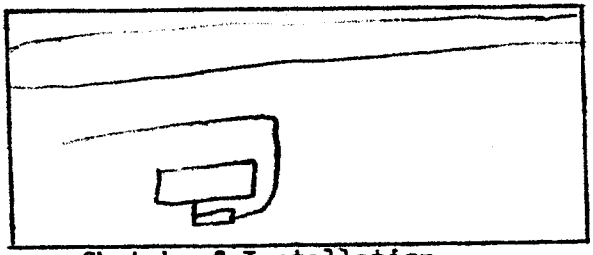

Sketch of Installation

Sanitarian