IREDELL COUNTY HEALTH DEPARTMENT

Statesville Phone TR 3-7271 Mooresville Phone NO 3-1271

PERMIT TO INSTALL SEPTIC TANK

Permit No. _____ Permit Date 1 - 7 1971

Owner HOPE Bros Builders INC Address STATESVILLE, NC.

Installed By ADAMS Septic Tank Service Address TAYLORSVILLE, NC.


Location of Property EAST Broad St. - Turn RIGHT on Saffiet Rd. Turn RIGHT 1st St. House NEAR Community WELL.

Tank		Capacity		Length of Lines		Fixtures	
Block	( )	1000	(✓)	225'	( )	No. of Baths	(1½)
Precast	(✓)	1250	( )	250'	( )	Dishwasher	( )
		1500	( )	Other 900		Garbage Grdr.	( )
		Other _____				Other _____	

NOTIFY HEALTH DEPARTMENT AT LEAST EIGHT HOURS BEFORE TANK IS TO BE INSPECTED.

Final Inspection 1 - 7 1971 Approved (Not Checked) Disapproved ( )

Remarks _____

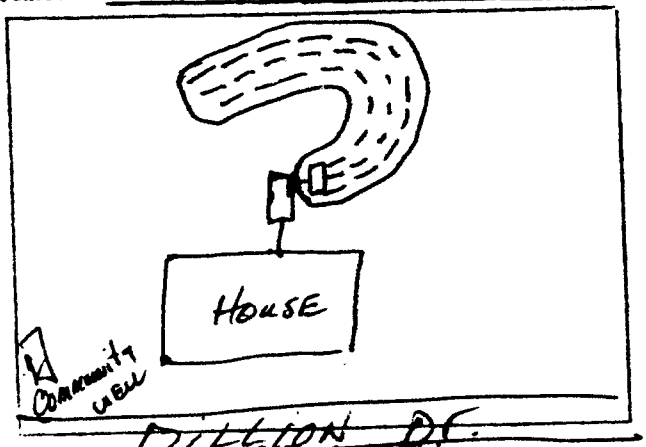


Sketch of Installation

Not Checked

Sanitarian