IREDELL COUNTY HEALTH DEPARTMENT

Statesville Phone TR 3-7271 Mooresville Phone NO 3-1271

PERMIT TO INSTALL SEPTIC TANK

Permit NO. _____ Permit Date FEB 18, 1959

Owner ALAN KNIGHT (BUD GAITHER) Address STATESVILLE

Installed By SAM GAITHER Address VA. AVE LOT # 18


Location of Property VIRGINIA AVE.

Tank		Capacity		Length of Lines		Fixtures	
Block	(✓)	800	( )	150'	( )	No. of Baths	(1)
Precast	( )	900	( )	175'	( )	Dishwasher	( )
		1000	(✓)	200'	( )	Garbage Grdr.	( )
		1100	( )	225'	(✓)	Auto-Washer	(1)
		1200	( )	250'	( )	Other	
		Other		Other			

NOTIFY HEALTH DEPARTMENT AT LEAST EIGHT HOURS BEFORE TANK IS TO BE INSPECTED.

Final Inspection FEB. 18, 1959 Approved (✓) Disapproved ( )

Remarks LINE WHICH COME IN FRONT OF HOUSE LOWEST OF THE TWO

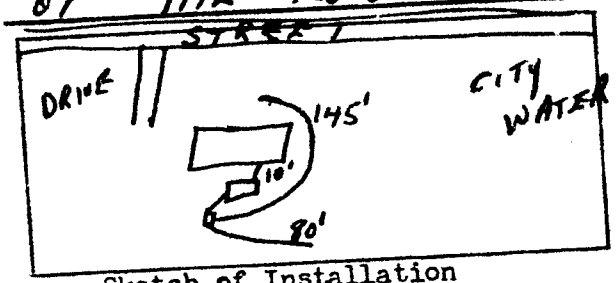

Sketch of Installation

Rayford A. Thomas
Sanitarian