IREDELL COUNTY HEALTH DEPARTMENT

Statesville Phone TR 3-7271 — Mooresville Phone NO 3-1271

PERMIT TO INSTALL SEPTIC TANK

Permit NO. _____ Permit Date 5 29 59 195_

Owner J C Grant Builder Address Va ave

Installed By C Hoke Address R7


Location of Property last on left on Virginia ave split level.

Tank		Capacity		Length of Lines		Fixtures	
Block	( )	800	(✓)	150'	( )	No. of Baths	(1½)
Precast	(✓)	900	( )	175'	( )	Dishwasher	( )
		1000	( )	200'	( )	Garbage Grdr.	( )
		1100	( )	225'	( )	Auto-Washer	(✓)
		1200	( )	250'	( )	Other	
		Other		Other 240 ft.			

NOTIFY HEALTH DEPARTMENT AT LEAST EIGHT HOURS BEFORE TANK IS TO BE INSPECTED.

Final Inspection 5 29 195 9 Approved (✓) Disapproved ( )

Remarks Lafayette Pa TEK City water.

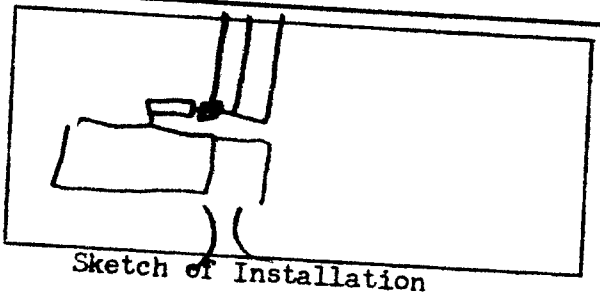

Sketch of Installation

R G L

Sanitarian