IREDELL COUNTY HEALTH DEPARTMENT

Statesville Phone TR 3-7271 — Mooresville Phone NO 3-1271

PERMIT TO INSTALL SEPTIC TANK

Permit NO. _____ Permit Date 4/29/59 195__

Owner J. C. Grant Address Virginia ave.

Installed By C. Hake Address Rte. 7 City


Location of Property last on right - facing lake.

Tank		Capacity		Length of Lines		Fixtures	
Block	( )	800	(4)	150'	( )	No. of Baths	(1)
Precast	(4)	900	( )	175'	( )	Dishwasher	(1)
		1000	( )	200'	( )	Garbage Grdr.	( )
		1100	( )	225'	( )	Auto-Washer	(1)
		1200	( )	250'	( )	Other	
		Other		Other	240		

NOTIFY HEALTH DEPARTMENT AT LEAST EIGHT HOURS BEFORE TANK IS TO BE INSPECTED.

Final Inspection 4 29 1959 Approved ( ) Disapproved ( )

Remarks Self app Pa TEK. City water

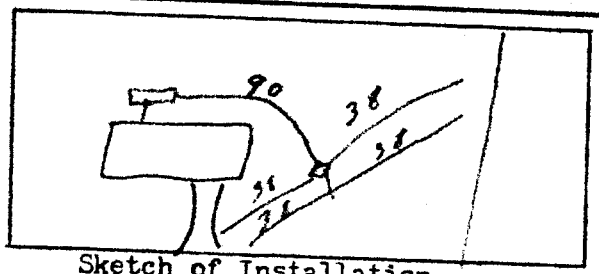

Sketch of Installation

RLZ

Sanitarian