Temp

IREDELL COUNTY HEALTH DEPARTMENT

Statesville Phone TR 3-7271 Mooresville Phone NO 3-1271

PERMIT TO INSTALL SEPTIC TANK

Permit NO. _____ Permit Date August 24 1960

Owner John Johnson Job Ralph Reavis Address Fulton Hghts

Installed By C Hoke Address R?


Location of Property _____

Tank		Capacity		Length of Lines		Fixtures	
Block	(4	800	( )	150'	( )	No. of Baths	( )
Precast	( )	900	( )	175'	( )	Dishwasher	( )
		1000	( )	200'	( )	Garbage Grdr.	( )
		1100	( )	225'	( )	Auto-Washer	( )
		1200	( )	250'	( )	Other	
		Other		Other 25'			

NOTIFY HEALTH DEPARTMENT AT LEAST EIGHT HOURS BEFORE TANK IS TO BE INSPECTED.

Final Inspection _____ 195_ Approved ( ) Disapproved ( )

Remarks 90 day temp hookup -

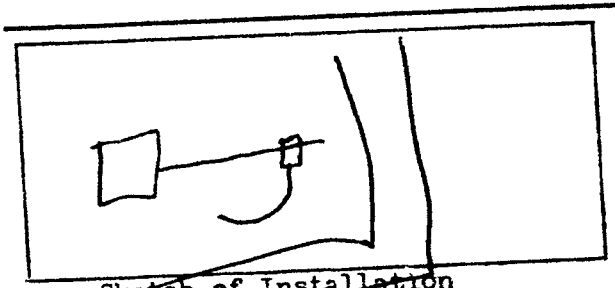

Sketch of Installation

Hook up made Jan 1961

Sanitarian