IREDELL COUNTY HEALTH DEPARTMENT

Statesville Phone TR 3-7271 Mooresville Phone NO 3-1271

PERMIT TO INSTALL SEPTIC TANK

Permit NO. #1 Permit Date JULY 23, 1960

Owner LINDY PEARSON Address 712 GEORGIA AVE

Installed By OSTWALT Address THOMASVILLE


Location of Property 712 GEORGIA AVE. - STA.

Tank		Capacity		Length of Lines		Fixtures	
Block	( )	800	( )	150'	( )	No. of Baths	(2)
Precast	(✓)	900	( )	175'	( )	Dishwasher	( )
		1000	(✓)	200'	( )	Garbage Grdr.	( )
		1100	( )	225'	( )	Auto-Washer	(1)
		1200	( )	250'	( )	Other	
		Other		Other			

NOTIFY HEALTH DEPARTMENT AT LEAST EIGHT HOURS BEFORE TANK IS TO BE INSPECTED.

Final Inspection JULY 23 1960 Approved (✓) Disapproved ( )

Remarks

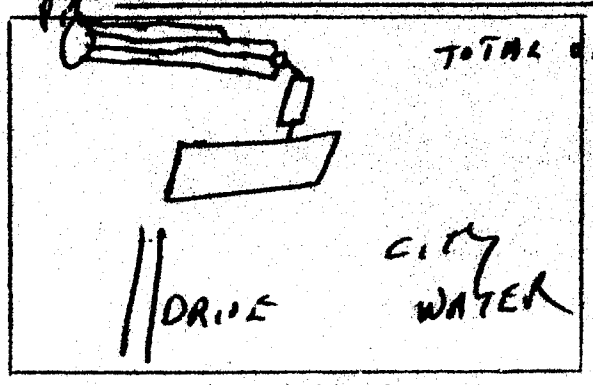

Sketch of Installation

Raford A. Adams

Sanitarian