42542

IREDELL COUNTY HEALTH DEPARTMENT

STATESVILLE 704-878-5305 MOORESVILLE 704-664-5281

IMPROVEMENT PERMIT / CERTIFICATE OF COMPLETION / OPERATION PERMIT / EXISTING SYSTEM INSPECTION

PROPERTY DESCRIPTION NO. Statesville DATE 6-8-93 TAX MAP NO. 6P-A-10

OWNER OR CONTRACTOR Winston Vaughan PHONE: Business 873-3471 Home

ADDRESS Rt 12 Box 531-A

LOCATION US 21 N past 4th creek Towards TL Pump Station Rd 1st to on Rt.

SUBDIVISION BLOCK / SECTION LOT LOT AREA 4.0 acres SITE CLASS. P3 L.T.A.R. .3

Water Supply: ☐ Individual ☐ Community ☑ Public

Septic Tank: 1000 Gallons; STB 358 Date 10-5-93

Pump Tank: Gallons; PT Date

Nitrification Field: No Fields 1 Square Feet 1035 Linear Feet 345

No Lines 3 Trench Width 36 Trench Depth 24 Gravel Depth 12

☑ New System ☐ Repair System Type: I. II. II. IV. V. VI

System Description: Conv. Gravity

Repair System Description:

Maintenance Agreement Required: ☐ Yes ☑ No

☐ House/Mod. Home No. Bedrooms 1 Garbage Disposal: ☐ Yes ☑ No

☐ Mobile Home No. Bathrooms 3 Auto. Dishwasher: ☐ Yes ☑ No


☐ Business No. Employees 3 Auto. Washing Machine: ☑ Yes ☐ No

☑ Other office & apt for mini storage Other


☐ Slab ☐ Crawl Space ☑ Basement w/plumbing ☐ Basement wo/plumbing

Comments

INITIAL SITE SKETCH

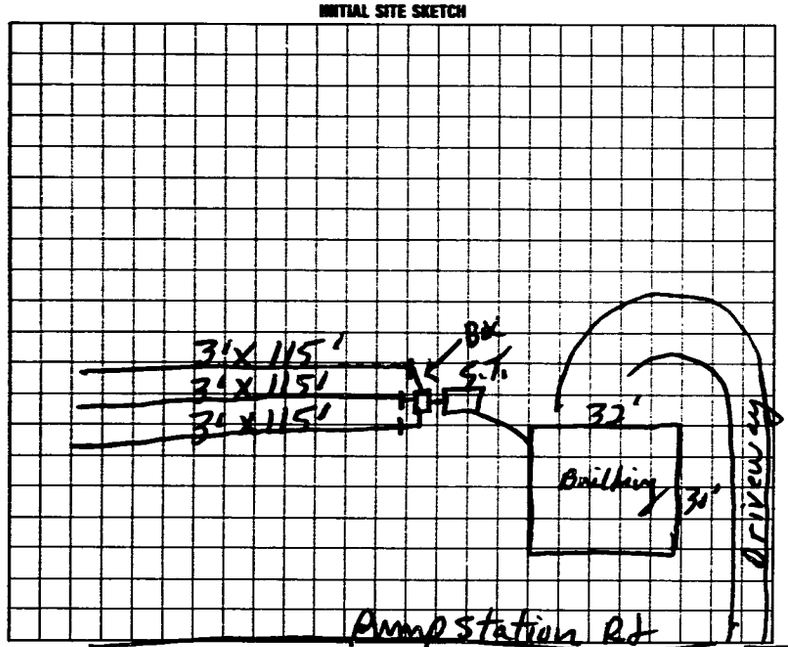

AS BUILT SKETCH

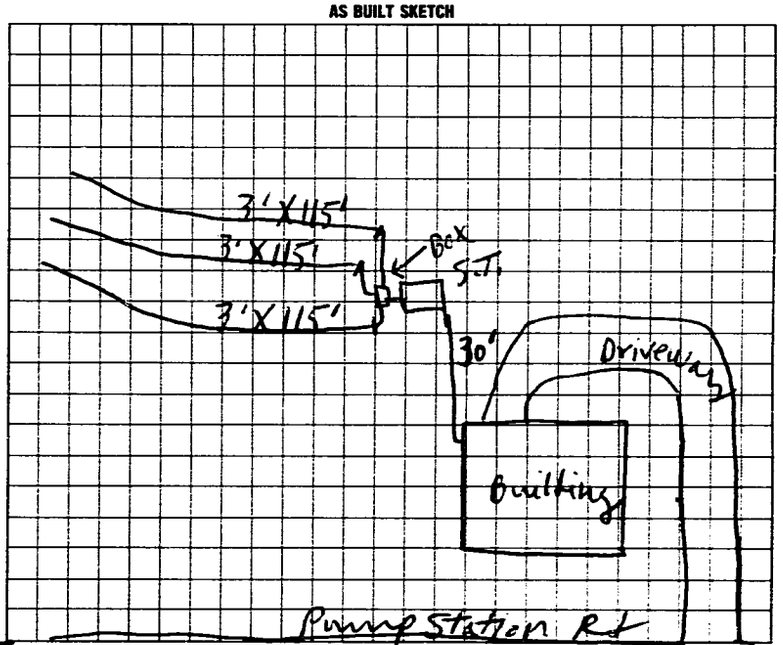

I understand that this permit can be suspended or revoked if any false information is supplied toward securing the permit/any unauthorized changes are made to the site/any unauthorized changes are made in the installation of the system. Improvement Permit is valid for 60 months from date of issuance.

Signed: X Winston Vaughan

Improvement Permit by: F. C. Moore date 6-8-93

Existing System Inspection by: date

Installed by: Steve Jordan

Certificate of Completion by: F. C. Moore date 11-19-93

Operation Permit by: date

HEALTH DEPT. COPY: WHITE INSPECTION COPY (FINAL): GREEN OWNER COPY (FINAL): YELLOW INSPECTION COPY (INITIAL): PINK OWNER COPY (INITIAL): GOLD