53550

IREDELL COUNTY HEALTH DEPARTMENT

STATESVILLE 704-878-5305 MOORESVILLE 704-664-5281

IMPROVEMENT PERMIT / CERTIFICATE OF COMPLETION / OPERATION PERMIT / EXISTING SYSTEM INSPECTION

PROPERTY DESCRIPTION NO. Statesville DATE 5-14-96 TAX MAP NO. 6P-A-10 Watershed: ☐ Yes ☐ No

OWNER OR CONTRACTOR Winston Mayhew PHONE: Business 873 3417 Home

ADDRESS 120 Pump Station Rd

LOCATION 2 N before Lowes Hardware on left

SUBDIVISION BLOCK / SECTION LOT LOT AREA 4.0 acres SITE CLASS PS DESIGN FLOW 150 L.T.A.R. .3

Septic Tank: 1000 Gallons; STB 358 Date 10-5-93
Pump Tank: Gallons; PT Date
Pump Make: Model Serial No.
Nitrification Field: No Fields 1 Square Feet 1035 Linear Feet 345
No Lines 3 Trench Width 36 Max Trench Bottom Depth 36

☐ New System ☐ Repair System Type: I, II, III, IV, V, VI
System Description: Conv. Gravity
Repair System Description: " "
Maintenance Agreement Required: ☐ Yes ☐ No
Gravel Depth 12" ☐ Slab ☐ Crawl Space ☑ Basement w/plumbing ☐ Basement wo/plumbing


☐ House/Mod. Home No. Bedrooms
☐ Mobile Home No. Bathrooms 5
☑ Business No. Employees
☐ Other Adding 1 office to ex. building

Water Supply:
☐ Individual
☐ Community
☑ Public


Comments:

Comments:

INITIAL SITE SKETCH

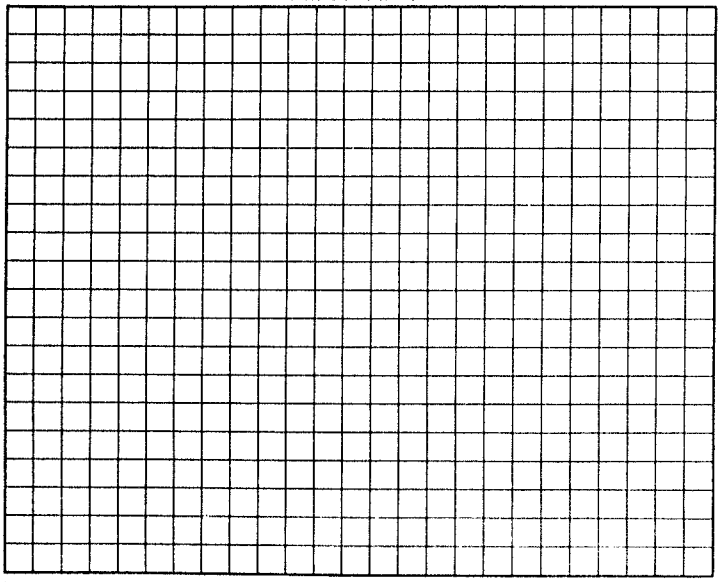

AS BUILT SKETCH

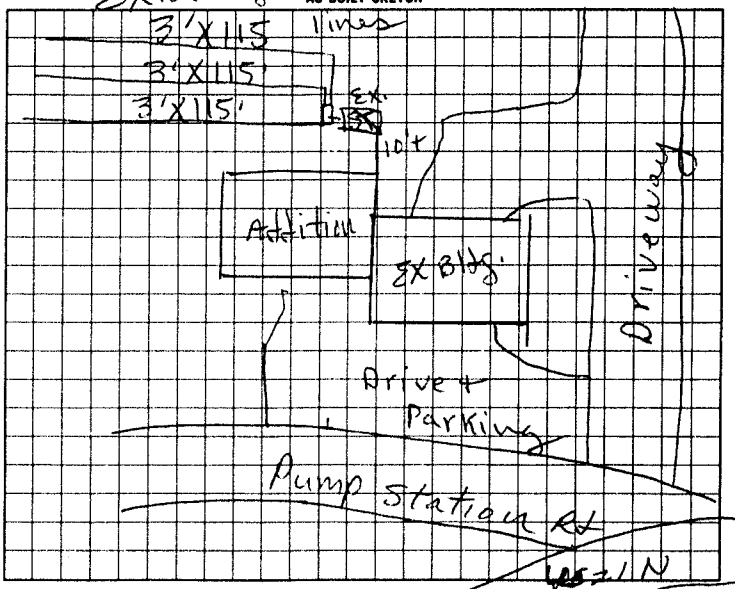

I understand that this permit can be suspended or revoked if any false information is supplied toward securing the permit/any unauthorized changes are made to the site/any unauthorized changes are made in the installation of the system

Signed:

Improvement Permit by: date

Existing System Inspection by: P.C. Moore date 5-14-96

Installed by Steve Jordan

Certificate of Completion by P.C. Moore date 11-19-93

Operation Permit by date

HEALTH DEPT. COPY: WHITE INSPECTION COPY (FINAL) GREEN OWNER COPY (FINAL) YELLOW INSPECTION COPY (INITIAL) PINK OWNER COPY (INITIAL) GOLD