62346

IREDELL COUNTY HEALTH DEPARTMENT

STATESVILLE 704-878-5305 MOORESVILLE 704-664-5281

62346

IMPROVEMENT PERMIT / CERTIFICATE OF COMPLETION / OPERATION PERMIT / EXISTING SYSTEM INSPECTION

PROPERTY DESCRIPTION NO. Statesville DATE 7-26-96 TAX MAP NO. 10C-2-A-14A Watershed: [ ] Yes [X] No

OWNER OR CONTRACTOR Clay & Avers PHONE: Business _____ Home 873 4448

ADDRESS 346 Turnersburg Hwy

LOCATION 21 N TR James Fm Rt, 2nd lot left

SUBDIVISION _____ BLOCK / SECTION _____ LOT _____ LOT AREA 174X150 SITE CLASS PS DESIGN FLOW 360 L.T.A.R. .13

Septic Tank: 1000 Gallons; STB 1012 Date 5-7-97

Pump Tank: _____ Gallons; PT _____ Date _____

Pump Make: _____ Model _____ Serial No. _____

Nitrification Field: No Fields 1 Square Feet 1200 Linear Feet 400

No Lines 4 Trench Width 36" Max Trench Bottom Depth 36" Gravel Depth 12"

[X] New System [ ] Repair System Type: I, II, III, IV, V, VI

System Description: Gravity Conv. Chambers

Repair System Description: _____

Maintenance Agreement Required: [ ] Yes [ ] No

[X] House/Mod. Home No. Bedrooms 3

[ ] Mobile Home No. Bathrooms 2

[ ] Business No. Employees _____

[ ] Other _____


[ ] Slab [X] Crawl Space [ ] Basement w/plumbing [ ] Basement wo/plumbing

Water Supply: [ ] Individual [ ] Community [X] Public

Comments:

Comments:

INITIAL SITE SKETCH

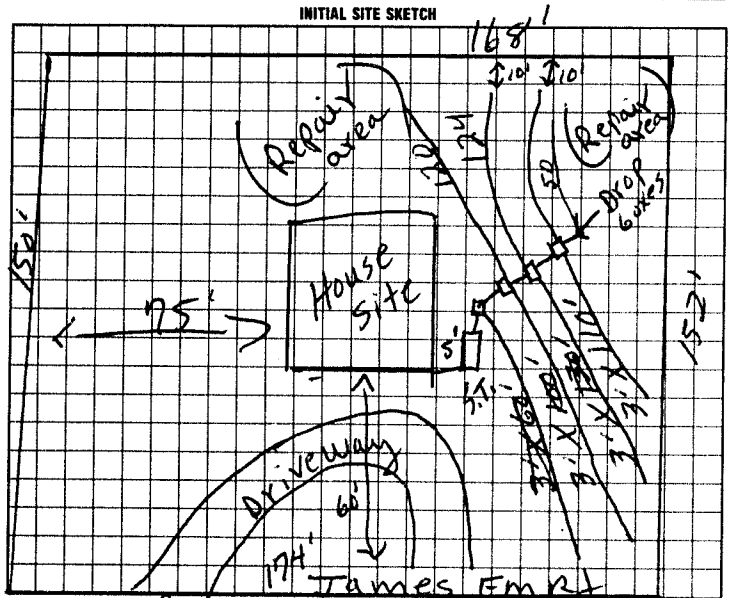

AS BUILT SKETCH

Installed as shown

I understand that this permit can be suspended or revoked if any false information is supplied toward securing the permit/any unauthorized changes are made to the site/any unauthorized changes are made in the installation of the system

Signed: X Clay Jimmy Avers

Improvement Permit by: P. C. Moore date 7-26-96

~~Existing System Inspection by:~~ Authorization to Const.

P. C. Moore date 7-26-96

Installed by: James Hudler

~~Certificate of Completion by:~~ _____ date _____

Operation Permit by: Mark C Ouf RS date 7-6-99

Authorization to Const. Expires 60 mos from issue

HEALTH DEPT. COPY: WHITE INSPECTION COPY (FINAL): GREEN OWNER COPY (FINAL): YELLOW INSPECTION COPY (INITIAL): PINK OWNER COPY (INITIAL): GOLD