IREDELL COUNTY HEALTH DEPARTMENT

Statesville Phone TR 3-7271 Mooresville Phone NO 3-1271

PERMIT TO INSTALL SEPTIC TANK

Permit NO. _____ Permit Date JUNE 22 1959

Owner LAND & RICKER (OLD DIXIE DAIRY) Address STATESVILLE, N.C.

Installed By HOKE Address _____


Location of Property OLD #64 JUST PAST OR PRESSLEY'S OFF LINE OR RIGHT

Tank		Capacity		Length of Lines		Fixtures	
Block	( )	800	(✓)	150'	( )	No. of Baths	(2)
Precast	(✓)	900	( )	175'	( )	Dishwasher	( )
		1000	( )	200'	( )	Garbage Grdr.	( )
		1100	( )	225'	(✓)	Auto-Washer	(1)
		1200	( )	250'	( )	Other	_____
		Other	_____	Other	_____		

NOTIFY HEALTH DEPARTMENT AT LEAST EIGHT HOURS BEFORE TANK IS TO BE INSPECTED.

Final Inspection JUNE 22 1959 Approved (✓) Disapproved ( )

Remarks Excellent Job —

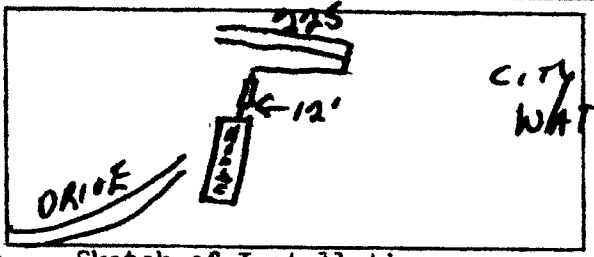

Sketch of Installation

Rafael A. Thomas

Sanitarian