IREDELL COUNTY HEALTH DEPARTMENT

STATESVILLE 704-878-5305 MOORESVILLE 704-664-5281

IMPROVEMENT PERMIT / AUTHORIZATION TO CONSTRUCT / OPERATION PERMIT / EXISTING SYSTEM INSPECTION

(c)

PERMIT# 140852 PIN# 4745-67046 699067 DATE 3-20-06

OWNER OR APPLICANT Terrance Hamby PHONE: Business 704-876-2654 Home

ADDRESS 252 maple cut Dr. 28625

LOCATION James Farm Rd Second Entrance Left

SUBDIVISION BLOCK / SECTION LOT 1 LOT AREA .506 SITE CLASS. B DESIGN FLOW 360 L.T.A.R. .13

Septic Tank: 1000 Gallons; STB Date 5-14-08

Pump Tank: Gallons; PT Date

Pump Make: Model Serial No.

Nitrification Field: No Fields Square Feet 1200 Linear Feet 300

No Lines 5 Trench Width 36" Max Trench Bottom Depth 36" Gravel Depth ☐ Gravity ☐ Pressure

☑ New System ☐ Repair ☐ Expansion System Type: I II III IV V VI

System Description: 25% GRAVITY

Repair System Description: 50% Low Pressure

Maintenance Agreement Required: ☐ Yes ☐ No

☑ House/Mod. Home No. Bedrooms 3

☐ Mobile Home No. Persons

☐ Business No. Employees

☐ Other

Water Supply: ☐ Individual ☑ Public ☐ Community

☐ Slab ☑ Crawl Space ☐ Basement w/plumbing ☐ Basement wo/plumbing


Comments:/Conditions:

Contact on Contractor
Maintain all setbacks


Comments:/Conditions:

Septic tank must be
Brand New

INITIAL SITE SKETCH

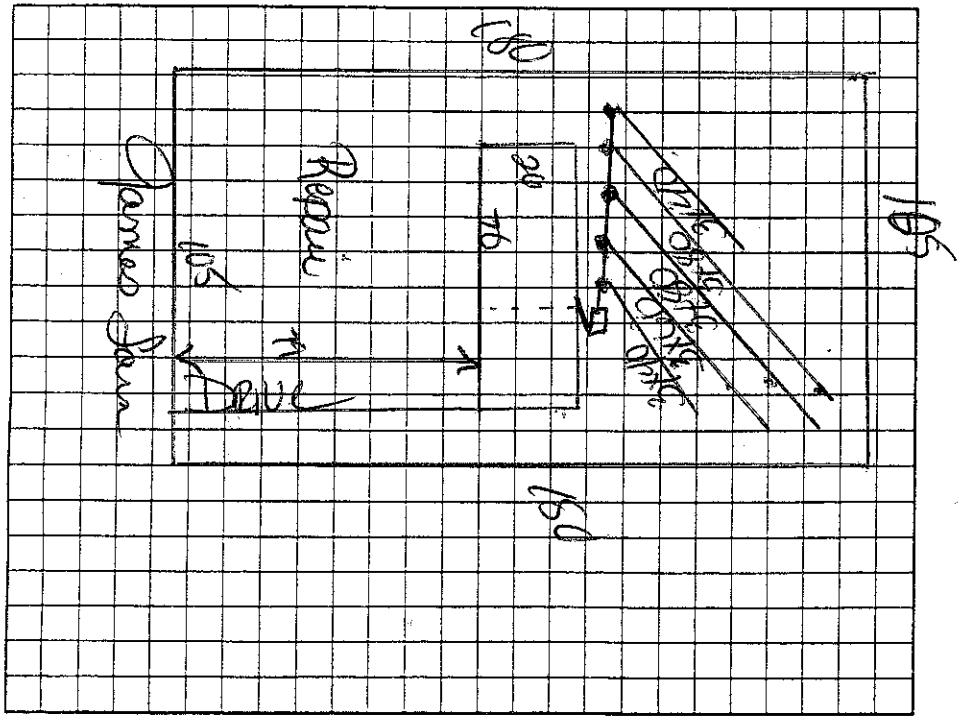

AS BUILT SKETCH

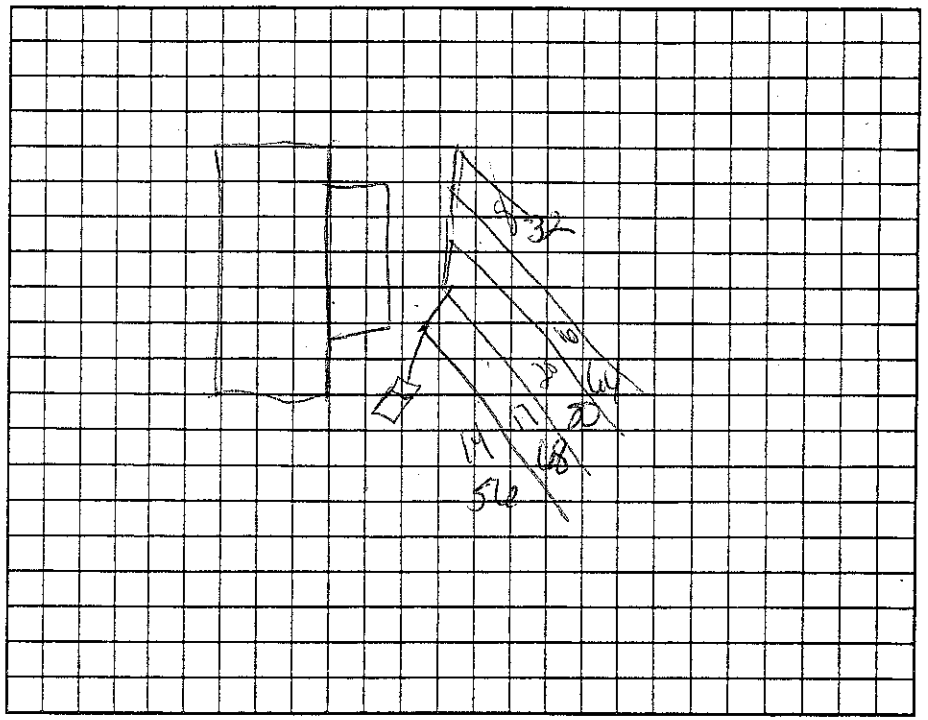

Permit can be suspended or revoked if any false information is supplied toward securing the permit/any unauthorized changes are made to the site/any unauthorized changes are made in the installation of the system. Improvement Permit with plat valid without expiration ☐ Improvement Permit with site plan valid for sixty months ☐ Authorization to Construct is valid for a period equal to that of Improvement Permit – not to exceed sixty months.

Signed: Jamie Hall date

Improvement Permit by: Kelly Cook date 3-2007

Authorization to Construct by: Kelly Cook date 3-2007

Installed by: Contractor / Septic Tank

Operation Permit by: Kelly Cook date 7-16-07

Existing System Inspection by: date

HEALTH DEPT. COPY: WHITE OWNER COPY (FINAL): YELLOW OWNER COPY (INITIAL): PINK