IREDELL COUNTY HEALTH DEPARTMENT

STATESVILLE 704-878-5305 MOORESVILLE 704-664-5281

IMPROVEMENT PERMIT / AUTHORIZATION TO CONSTRUCT / OPERATION PERMIT / EXISTING SYSTEM INSPECTION

PERMIT# 92986 PIN# 10CA DATE 7/20/01

OWNER OR CONTRACTOR Benjamin Pilfer PHONE: Business (704)902-3792 Home (704)871-9779

ADDRESS 319 S. Race Street Statesville N.C. 28677 (Rocky Lane)

LOCATION Ft Dobbs, (R) Cooper Farm, 1st road to right (East Green house, 1/mile on left, 700' off Rocky Lane

SUBDIVISION — BLOCK / SECTION — LOT — LOT AREA — SITE CLASS PS DESIGN FLOW 360 L.T.A.R. .3

Septic Tank: 1,000 Gallons: STB 825 Date 8-7-00
Pump Tank: — Gallons: PT — Date —
Pump Make: — Model — Serial No —
Nitrification Field: No Fields 1 Square Feet 1200 Linear Feet 400
No Lines 4@100' Trench Width 36" Max Trench Bottom Depth 36" Gravel Depth 12"

(X) New System ☐ Repair System Type: I (II) III. IV. V. VI
System Description: Gravity, Conventional
Repair System Description: Gravity 25% Reduction
Maintenance Agreement Required: ☐ Yes (X) No


(X) House/Mod. Home No. Bedrooms 3
☐ Mobile Home No. Bathrooms 2
☐ Business No. Employees —
☐ Other —
☐ Slab ☐ Crawl Space (X) Basement w/plumbing ☐ Basement wo/plumbing

Water Supply: (X) Individual ☐ Public ☐ Community


Comments/Conditions: (1) Install lines on contour (2) keep 100ft From well (2) keep 15 From basement tank + Lines

Comments/Conditions: — PVC Lok-Filter — Septic Tank Risers Installed

INITIAL SITE SKETCH Not to Scale

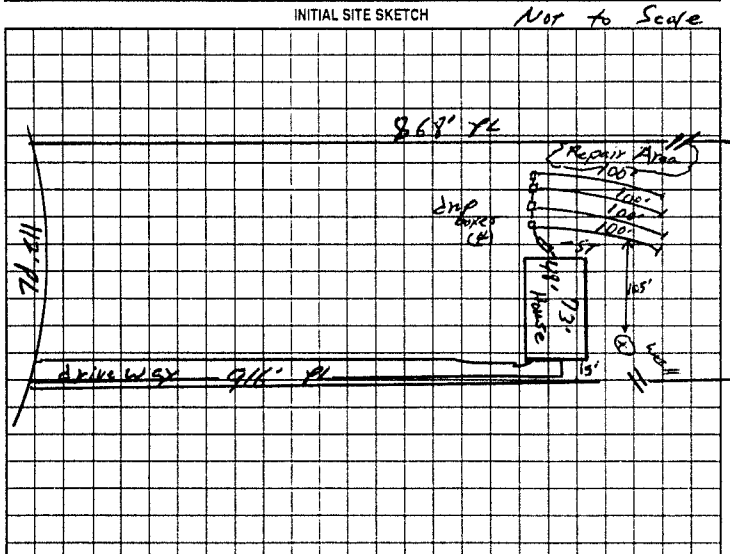

AS BUILT SKETCH

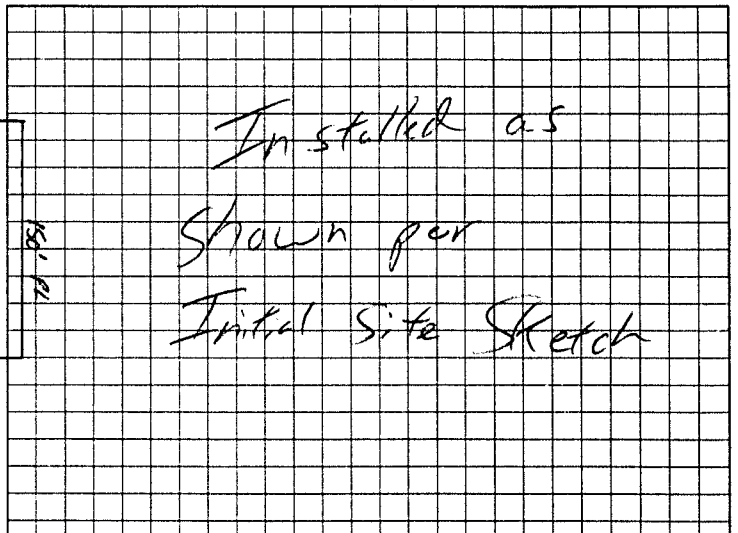

Permit can be suspended or revoked if any false information is supplied toward securing the permit/any unauthorized changes are made to the site/any unauthorized changes are made in the installation of the system. Improvement Permit with plat valid without expiration. Improvement Permit with site plan valid for sixty months. Authorization to Construct is valid for a period equal to that of Improvement Permit – not to exceed sixty months.

Signed: — date —

Improvement Permit by: William O. Johnson date 7/20/01

Authorization to Construct by: William O. Johnson date 7/20/01

Installed by: Statesville Backhoe

Operation Permit by: William O. Johnson date 10/4/01

Existing System Inspection by: — date —

HEALTH DEPT. COPY WHITE OWNER COPY (FINAL) YELLOW OWNER COPY (INITIAL) PINK