IREDELL COUNTY HEALTH DEPARTMENT

Statesville Phone TR 3-7271 Mooresville Phone NO 3-1271

PERMIT TO INSTALL SEPTIC TANK

Permit NO. U E Lawrence - Buckle Permit Date Oct. 11 1962

Owner Snyder Address Freedom Dr.

Installed By CLYDE HOKE RT. 7 BOX 2?? Address Rte. 7, City


Location of Property out Shipley Ford Rd to 1st. Paved Rd to R. New on left 3/4 mile

Tank		Capacity		Length of Lines		Fixtures	
Block	( )	800	( )	150'	( )	No. of Baths	( )
Precast	(✓)	900	( )	175'	( )	Dishwasher	( )
		1000	(✓)	200'	( )	Garbage Grdr.	( )
		1100	( )	225'	(✓)	Auto-Washer	( )
		1200	( )	250'	( )	Other	
		Other		Other			

NOTIFY HEALTH DEPARTMENT AT LEAST EIGHT HOURS BEFORE TANK IS TO BE INSPECTED.

Final Inspection 10-11 1962 Approved (✓) Disapproved ( )

Remarks well 65'

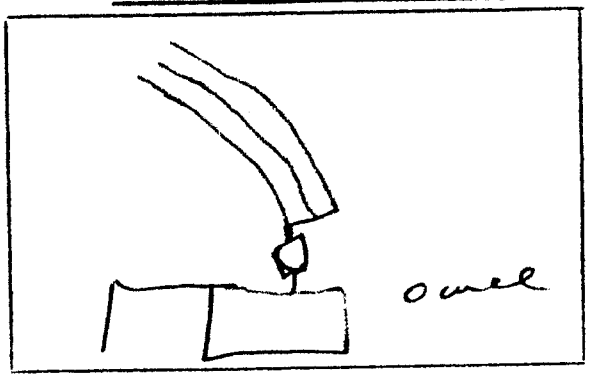

Sketch of Installation

Rat

Sanitarian