IREDELL COUNTY HEALTH DEPARTMENT

STATESVILLE 704-878-5305 MOORESVILLE 704-664-5281 JC 7-22-08

IMPROVEMENT PERMIT / AUTHORIZATION TO CONSTRUCT / OPERATION PERMIT / EXISTING SYSTEM INSPECTION

PERMIT# 150344 PIN# 4746182069 DATE 5-30-08

OWNER OR APPLICANT CMH Homes, Inc PHONE: Business 704 746 4778 Home

ADDRESS 122 Ritchie Lane

LOCATION 21 N (TL) on Shumaker (TL) on Nixon (TR) on Mason (TR) on Ritchie, home at end on (R) at dead end

SUBDIVISION n/a BLOCK / SECTION LOT n/a LOT AREA .9 SITE CLASS RS DESIGN FLOW 360 L.T.A.R. Existing

Septic Tank: Existing Gallons: STB Existing Date

Pump Tank: Gallons: PT Date

Pump Make: Model Serial No.

Nitrification Field: No Fields 1 Square Feet Ex Linear Feet Ex

No Lines Ex Trench Width Ex Max Trench Bottom Depth Ex Gravel Depth ☐ Gravity ☐ Pressure

☐ New System ☐ Repair ☐ Expansion System Type: I (II) III IV V VI

System Description: Existing

Repair System Description:

Maintenance Agreement Required: ☐ Yes ☐ No

☐ House/Mod. Home No. Bedrooms 3

◉ Mobile Home No. Persons

☐ Business No. Employees

☐ Other


Water Supply: ◉ Individual ☐ Public ☐ Community

☐ Slab ◉ Crawl Space ☐ Basement w/plumbing ☐ Basement wo/plumbing


Comments:/Conditions:

Comments:/Conditions:

INITIAL SITE SKETCH

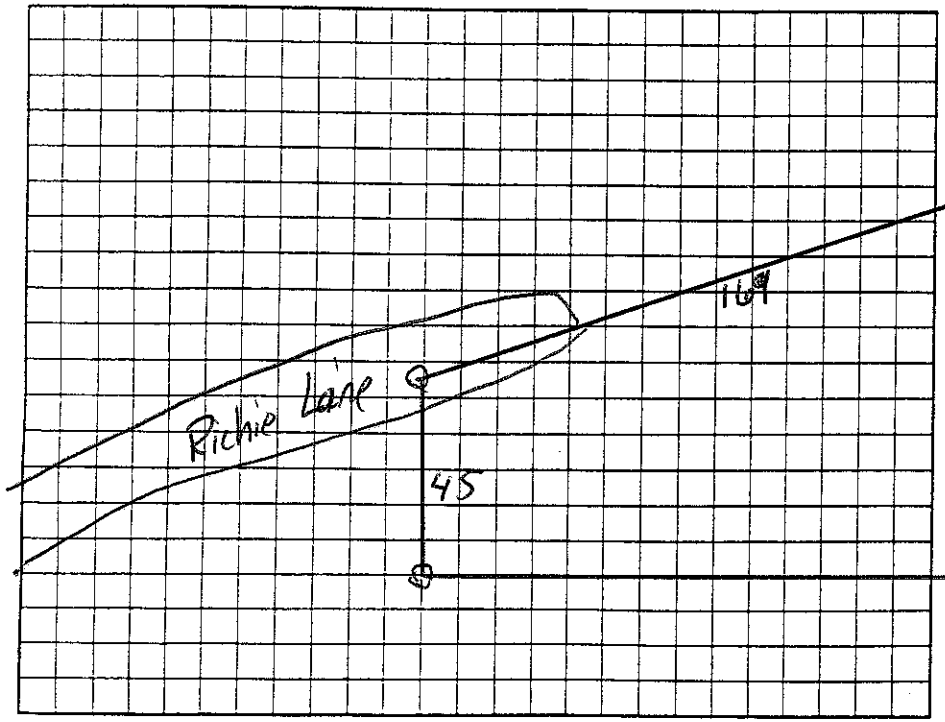

AS BUILT SKETCH

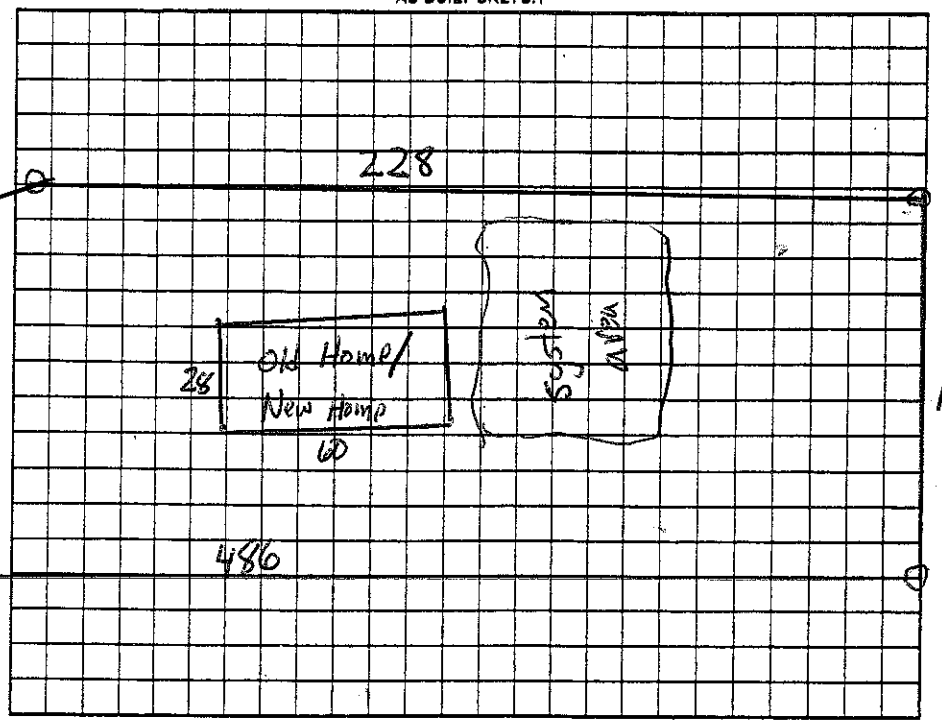

Permit can be suspended or revoked if any false information is supplied toward securing the permit/any unauthorized changes are made to the site/any unauthorized changes are made in the installation of the system. Improvement Permit with plat valid without expiration ☐ Improvement Permit with site plan valid for sixty months ☐ Authorization to Construct is valid for a period equal to that of Improvement Permit – not to exceed sixty months.

Signed: Eric M. Ware date 6-2-08 Installed by:

Improvement Permit by: date Operation Permit by: date

Authorization to Construct by: date Existing System Inspection by: James X date 5-30-08

HEALTH DEPT. COPY: WHITE OWNER COPY (FINAL): YELLOW OWNER COPY (INITIAL): PINK