IREDELL COUNTY HEALTH DEPARTMENT

Statesville Office (704) 878-5305 Mooresville Office (704) 380-3825 PERMIT # 221640

IMPROVEMENT PERMIT / AUTHORIZATION TO CONSTRUCT / OPERATION PERMIT / EXISTING SYSTEM

PIN # 4746-18-7891

APPLICANT: BOB FARMER APPLICANT ADDRESS: 133 SQUIRE COURT STATESVILLE

SITE ADDRESS: SAME PHONE: 704-402-2769 ALT. PHONE:

SITE DIRECTIONS: 21N, TL SHUMAKER, TL NIXON, TR KINGSWOOD, TL SQUIRE, ON L CEND

SUBDIVISION: KINGSWOOD SECTION: 2 LOT # 85 LOT AREA: DESIGN FLOW: 360 L.T.A.R.:

Septic Tank 1000 (gal) STB 760 Date 6/24/16
Pump Tank (gal) PT Date
Pump Make Model Serial #
Nitrification Fields # Lines EXISTING Linear Ft:
Trench Width Max. Trench Bottom Depth Gravel Depth


☐ New System ☑ Repair ☐ Expansion System Type: I (II) III IV V VI
System Description:
Repair System Description: TANK
Maintenance Agreement Required: ☐ YES ☑ NO
☑ GRAVITY ☐ PRESSURE

☑ Residence No. Bedrooms 3
☐ Business No. Persons 6
☐ Other No. Employees
☐ Slab ☐ Crawl Space
☐ Basement w/plumbing ☑ Basement w/o plumbing


Water Supply: ☐ Private ☑ Public ☐ Community

Comments / Conditions: INSTALL NEW 1000 GAL. TANK AS SHOWN. UNCOVER D-BOX. INSTALL NEW BOX IF NEEDED. USE SPEED LEVELERS IN D-BOX TO LEVEL

INITIAL SITE SKETCH

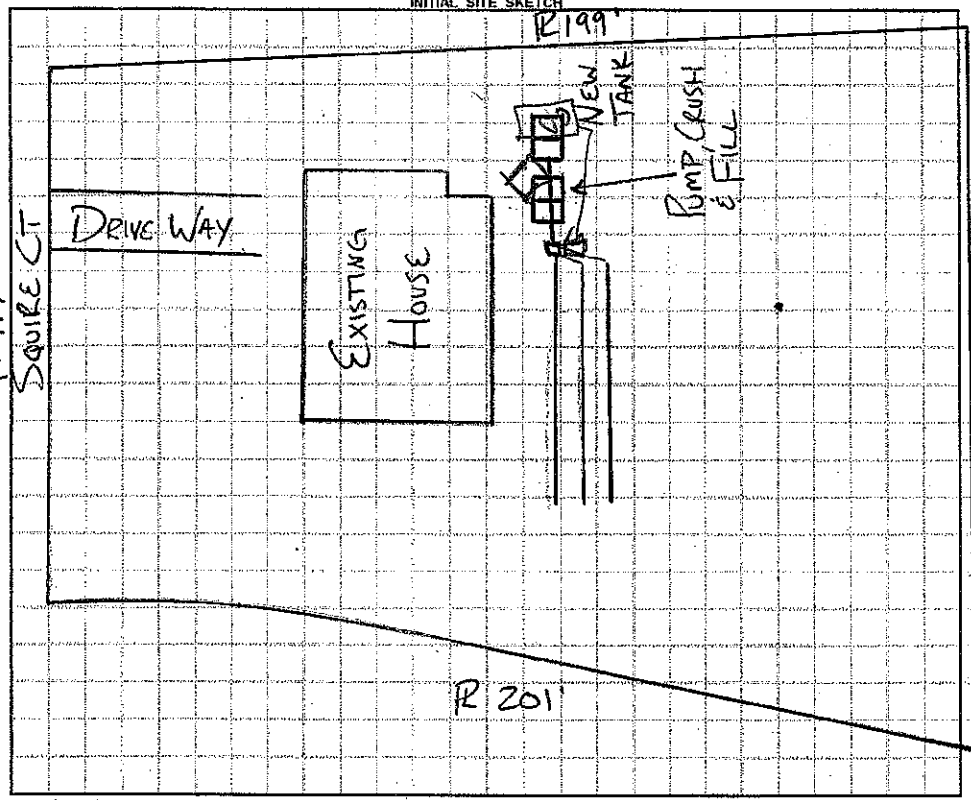

AS BUILT SKETCH

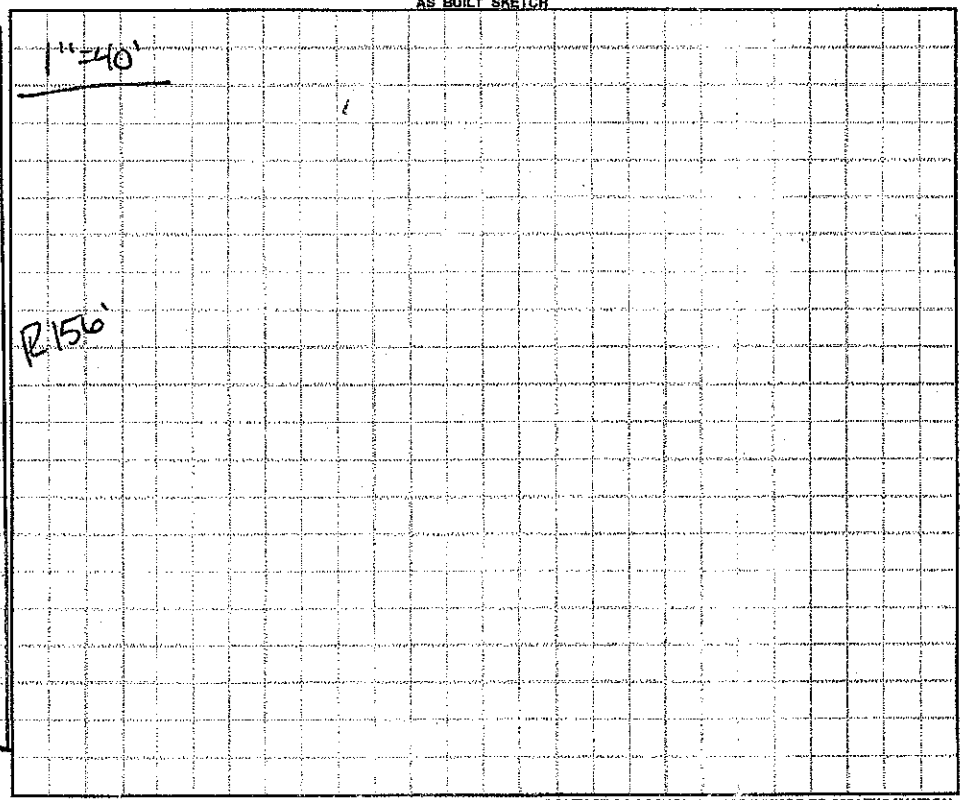

Permit can be suspended or revoked if any false information is supplied toward securing the permit / any unauthorized changes are made to the site / any unauthorized changes are made in the installation of the system. **CONTACT A LOCATOR SERVICE PRIOR TO ANY EXCAVATION**

☐ **IMPROVEMENT PERMIT** *with plat valid without expiration.* ☑ **IMPROVEMENT PERMIT** *with site plan valid for 60 mos.* ☑ **AUTHORIZATION TO CONSTRUCT** *valid for period equal to IMPROVEMENT PERMIT--not to exceed 60 mo.*

Owner / Applicant Signature: Wanda Farmer Date: 9-26-16 Installed by: Leggett

IMPROVEMENT PERMIT by: RA Date: 9-15-16 OPERATION PERMIT by: Date: 10/3/16

AUTHORIZATION TO CONSTRUCT by: RA Date: 9-15-16 Existing System Inspected by: Date:

Health Dept. Copy - WHITE Applicant (Final Approval) - YELLOW Applicant (Conditional Approval) - PINK