IREDELL COUNTY HEALTH DEPARTMENT

STATESVILLE 704-878-5305 MOORESVILLE 704-664-5281

IMPROVEMENT PERMIT / AUTHORIZATION TO CONSTRUCT / OPERATION PERMIT / EXISTING SYSTEM INSPECTION

PERMIT# 86052 PIN# [redacted] 4746214848 DATE 11-2-99

OWNER OR CONTRACTOR Kenneth Woiner PHONE: Business 412-829-7666 Home

ADDRESS 1442 Justyln Monroe PA 15146

LOCATION 21N To Rimbner 4th lot Past Fairgate on Rt.

SUBDIVISION Fairview Fms BLOCK / SECTION LOT 20 LOT AREA 1.76 acres SITE CLASS PS DESIGN FLOW 360 L.T.A.R. .35 gal/sq ft/day

Septic Tank: 1000 Gallons; STB 1000 Date 10-10-00
Pump Tank: Gallons; PT Date
Pump Make: Model Serial No.
Nitrification Field: No Fields 1 Square Feet 1045 Linear Feet 345
No Lines 3 Trench Width 36" Max Trench Bottom Depth 36" Gravel Depth 12"

☑ New System ☐ Repair System Type: I, II, III, IV, V, VI
System Description: Conv. Gravity
Repair System Description:
Maintenance Agreement Required: ☐ Yes ☑ No
☐ Slab ☑ Crawl Space ☐ Basement w/plumbing ☐ Basement wo/plumbing


☐ House/Mod. Home No. Bedrooms 3
☐ Mobile Home No. Bathrooms 2
☐ Business No. Employees
☐ Other

Water Supply: ☐ Individual ☑ Public ☐ Community

Comments/Conditions:

Comments/Conditions: SEPTIC TANK W/ MARKER
WSTALLED USING "POLY LOK" FILTER

INITIAL SITE SKETCH

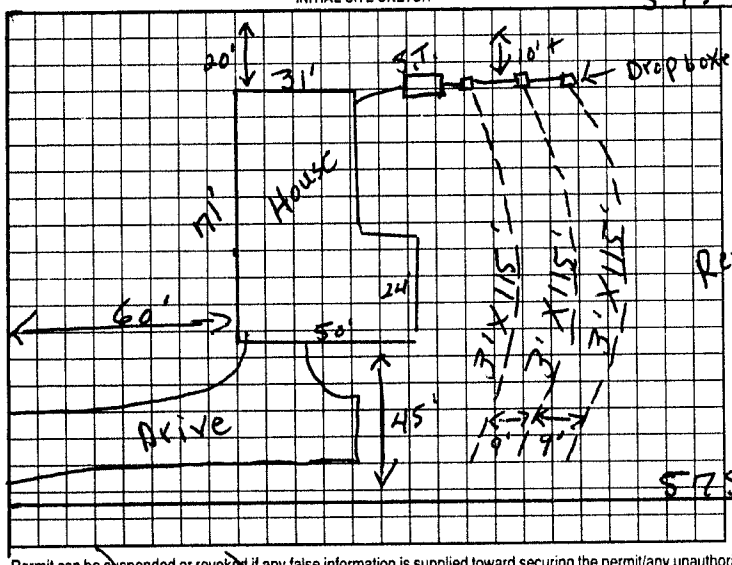

AS BUILT SKETCH

SYSTEM WSTALLED ACCORDING TO INIAL SITE SKETCH

Permit can be suspended or revoked if any false information is supplied toward securing the permit/any unauthorized changes are made to the site/any unauthorized changes are made in the installation of the system. Improvement Permit with plat valid without expiration. Improvement Permit with site plan valid for sixty months. Authorization to Construct is valid for a period equal to that of Improvement Permit – not to exceed sixty months.

Signed: [signature] date Installed by: JAMES HUBER

Improvement Permit by: P.C. Moore date 11-2-99 Operation Permit by: STEVE HERRICK date 12-6-00

Authorization to Construct by: P.C. Moore date 11-2-99 Existing System Inspection by: date

HEALTH DEPT. COPY: WHITE OWNER COPY (FINAL): YELLOW OWNER COPY (INITIAL): PINK