called IN

IREDELL COUNTY HEALTH DEPARTMENT

STATESVILLE 704-878-5305 MOORESVILLE 704-664-5281

IMPROVEMENT PERMIT / AUTHORIZATION TO CONSTRUCT / OPERATION PERMIT / EXISTING SYSTEM INSPECTION

(J)

PERMIT# 128246 PIN# 4746-22-6060 (TERRY O'BRIEN) DATE 6-25-05

OWNER OR CONTRACTOR JENNIFER MYERS PHONE: Business 704-902-4310(c) Home 704-682-1538

ADDRESS 123 FAIRGATE DR, STATESVILLE, NC 28625

LOCATION US 21 NORTH TL RIMMER ROAD, CONTINUE ZURICH LANE, LOT # 28 ON LEFT (3RD BEFORE END)

SUBDIVISION FAIRVIEW FARMS BLOCK / SECTION LOT 28 LOT AREA 1.919 ACRES SITE CLASS. PS DESIGN FLOW 480 L.T.A.R. 0.35 GPD/FT²

Septic Tank: 1000 Gallons; STB TT 1017 Date 3-29-05

Pump Tank: Gallons; PT Date

Pump Make: Model Serial No.

Nitrification Field: No Fields 1 Square Feet 1371 Linear Feet 345

No Lines FIVE Trench Width 36" Max Trench Bottom Depth 36" Gravel Depth N/A

☑ New System ☐ Repair System Type: I (II) III, IV, V, VI

System Description: 25% REDUCTION GRAVITY

Repair System Description: 25% REDUCTION, GRAVITY

Maintenance Agreement Required: ☐ Yes ☑ No

☑ House/Mod. Home ☐ Mobile Home ☐ Business ☐ Other

No. Bedrooms 4 No. Bathrooms No. Employees


☐ Slab ☑ Crawl Space ☐ Basement w/plumbing ☐ Basement wo/plumbing

Water Supply: ☐ Individual ☑ Public ☐ Community


Comments:/Conditions: INSTALL 25% REDUCTION SYSTEM ON CONTOUR AS SHOWN.

Comments:/Conditions: Yellow Fitter Septic Tank Marker

INITIAL SITE SKETCH

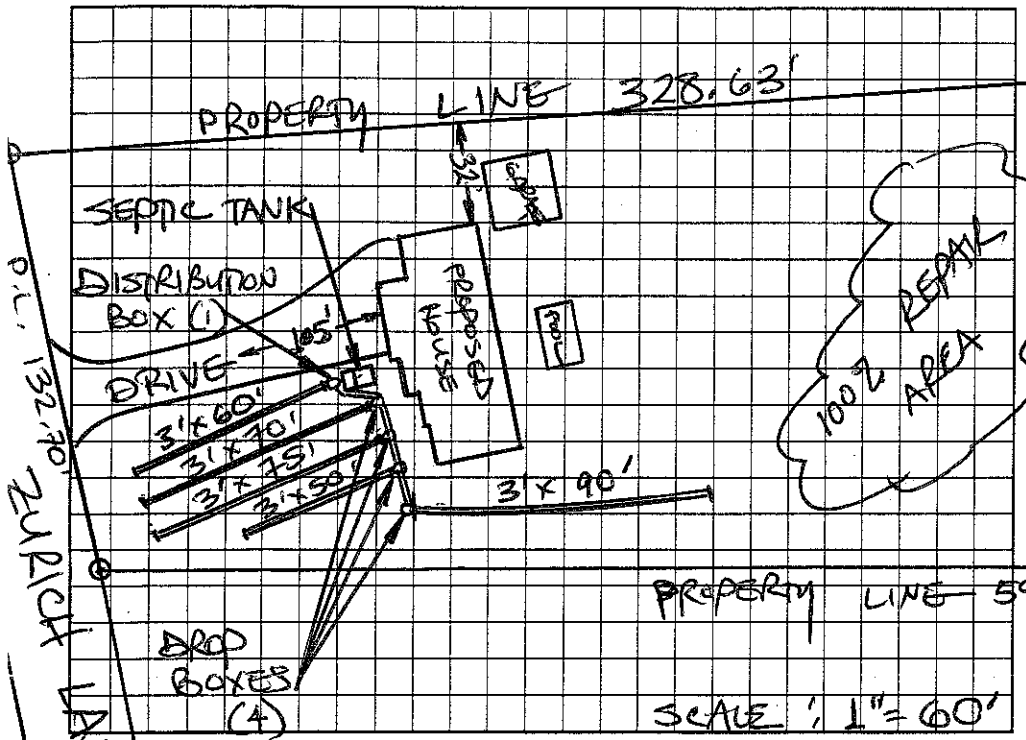

AS BUILT SKETCH

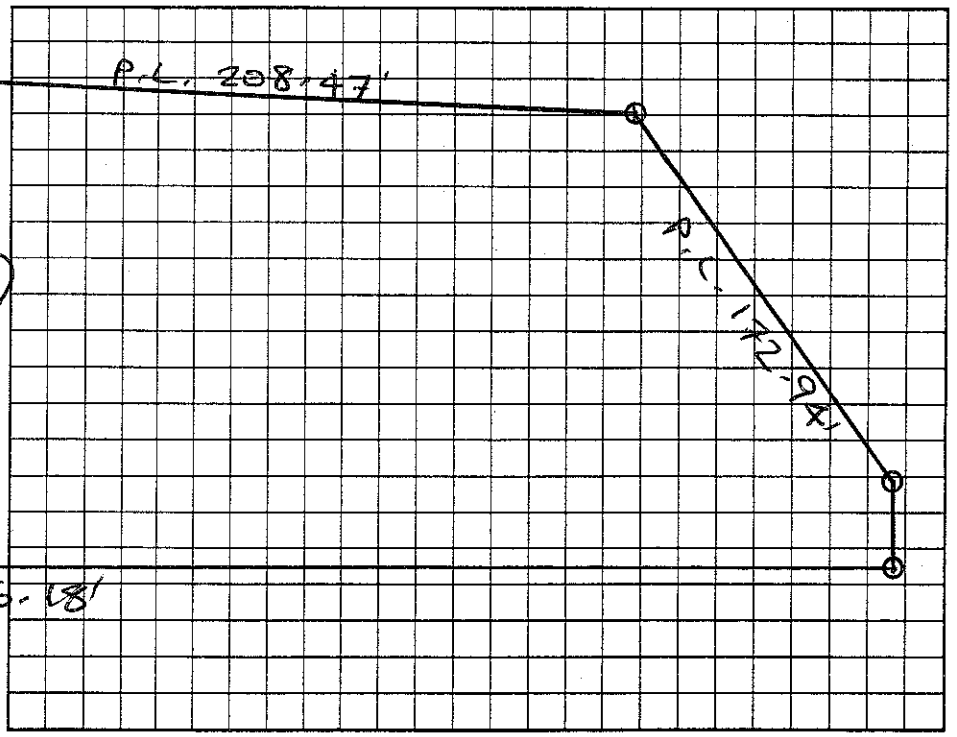

Permit can be suspended or revoked if any false information is supplied toward securing the permit/any unauthorized changes are made to the site/any unauthorized changes are made in the installation of the system. Improvement Permit with plat valid without expiration. Improvement Permit with site plan valid for sixty months. Authorization to Construct is valid for a period equal to that of Improvement Permit – not to exceed sixty months.

Signed: X [signature] date 6-25-05 Installed by: Steve Jordan

Improvement Permit by: STEVE HEDRICK date 6-25-05 Operation Permit by: James Stewart date 10/31/05

Authorization to Construct by: STEVE HEDRICK date 6-25-05 Existing System Inspection by: date

HEALTH DEPT. COPY: WHITE OWNER COPY (FINAL): YELLOW OWNER COPY (INITIAL): PINK