IREDELL COUNTY HEALTH DEPARTMENT

STATESVILLE 704-878-5305 MOORESVILLE 704-664-5281

IMPROVEMENT PERMIT / AUTHORIZATION TO CONSTRUCT / OPERATION PERMIT / EXISTING SYSTEM INSPECTION

PERMIT# 97707 PIN# 4746 22 8230 DATE 2-2-00

OWNER OR CONTRACTOR CCS Inc. PHONE: Business 924-8635 Home

ADDRESS 130 Dobb Dr. Statesville

LOCATION 21 N TL Rimmer Dr. 1/4 mi on left.

SUBDIVISION Fairview Em. BLOCK / SECTION [redacted] LOT 29 LOT AREA .61 acres SITE CLASS. PS DESIGN FLOW 360 L.T.A.R. .33

Septic Tank: 1000 Gallons; STB 794 Date 12/1/00

Pump Tank: Gallons; PT Date

Pump Make: Model Serial No.

Nitrification Field: No Fields 1 Square Feet 1080 Linear Feet 360

No Lines 5 Trench Width 36" Max Trench Bottom Depth 36" Gravel Depth 12"

☑ New System ☐ Repair System Type: I II III IV V VI

System Description: Conv. Gravity

Repair System Description: Gravity 75% Reduction

Maintenance Agreement Required: ☐ Yes ☑ No

☑ House/Mod. Home No. Bedrooms 3

☐ Mobile Home No. Bathrooms 2

☐ Business No. Employees

☐ Other


☐ Slab ☑ Crawl Space ☐ Basement w/plumbing ☐ Basement wo/plumbing

Water Supply: ☐ Individual ☑ Public ☐ Community

Comments:/Conditions:

Comments /Conditions.

INITIAL SITE SKETCH 189'

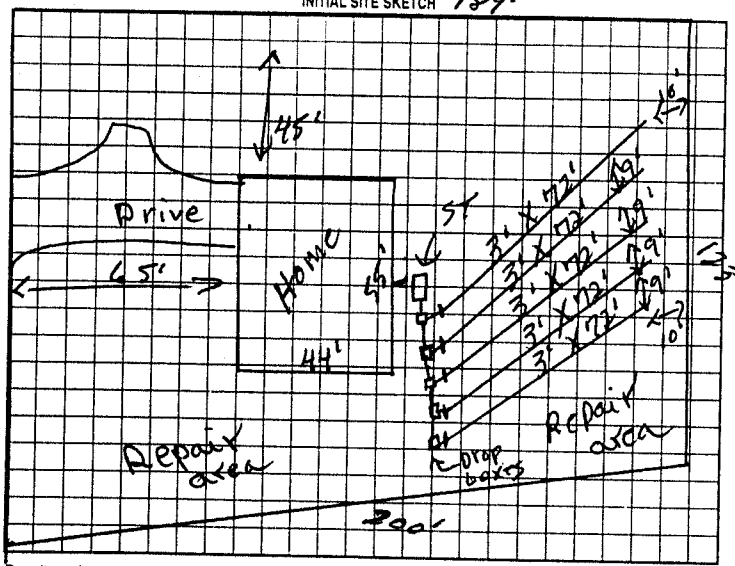

AS BUILT SKETCH

Permit can be suspended or revoked if any false information is supplied toward securing the permit/any unauthorized changes are made to the site/any unauthorized changes are made in the installation of the system. Improvement Permit with plat valid without expiration. Improvement Permit with site plan valid for sixty months. Authorization to Construct is valid for a period equal to that of Improvement Permit - not to exceed sixty months.

Signed: [signature] date 2-3-00 Installed by: Craig Thompson

Improvement Permit by: P.C. Moore date 2-2-00 Operation Permit by: [signature] RST date 8/10/00

Authorization to Construct by: P.C. Moore date 2-2-00 Existing System Inspection by: date

HEALTH DEPT. COPY: WHITE OWNER COPY (FINAL): YELLOW OWNER COPY (INITIAL): PINK