IREDELL COUNTY HEALTH DEPARTMENT

Statesville Phone TR 3-7271 Mooresville Phone No. 664-5281

PERMIT TO INSTALL SEPTIC TANK

Permit No. 1 / 1 Bldr. Holbrook Permit Date 2-5 19 73

Owner ALFRED LEVAN Address STATESVILLE, NC

Installed By HERMAN GIBSON Address STATESVILLE, N.C.

Location of Property IREDELL HEIGHTS

DEVON DR.


LOT #' 1394 - 1398

Tank		Capacity		Length of Lines		Fixtures	
Block	( )	1000	(✓)	225'	( )	No. of Baths	(1½)
Precast	(✓)	1250	( )	250'	( )	Dishwasher	( )
		1500	( )	Other 300		Garbage Grdr.	( )
		Other		900 sq ft.		Other	

NOTIFY HEALTH DEPARTMENT AT LEAST EIGHT HOURS BEFORE TANK IS TO BE INSPECTED.

Final Inspection 2-5 19 73 Approved (✓) Disapprcved ( )

Remarks IREDELL WATER CO.

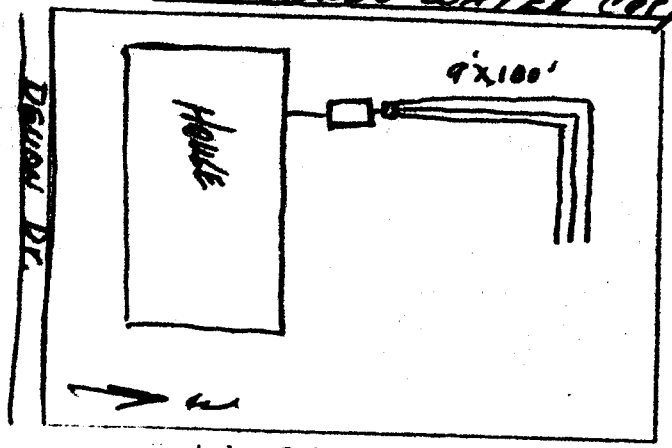

Sketch of Installation

Sanitarian