IREDELL COUNTY HEALTH DEPARTMENT

Statesville Phone TR 3-7271 Mooresville Phone No. 664-5281

PERMIT TO INSTALL SEPTIC TANK

Permit No. 112 Permit Date 5-30 1973

Owner Hope Bro Address Statesville N.C.

Installed By Same Address


Location of Property Iredell Heights on Devon Lane Lot # 56 House on L.

Tank		Capacity		Length of Lines		Fixtures	
Block	( )	1000	(✓)	225'	( )	No. of Baths	(1½)
Precast	(✓)	1250	( )	250'	( )	Dishwasher	( )
		1500	( )	Other 300		Garbage Grdr.	( )
		Other		900 sq ft		Other	

NOTIFY HEALTH DEPARTMENT AT LEAST EIGHT HOURS BEFORE TANK IS TO BE INSPECTED.

Final Inspection 5-30 1973 Approved (✓) Disapproved ( )

Remarks Iredell Water Corp

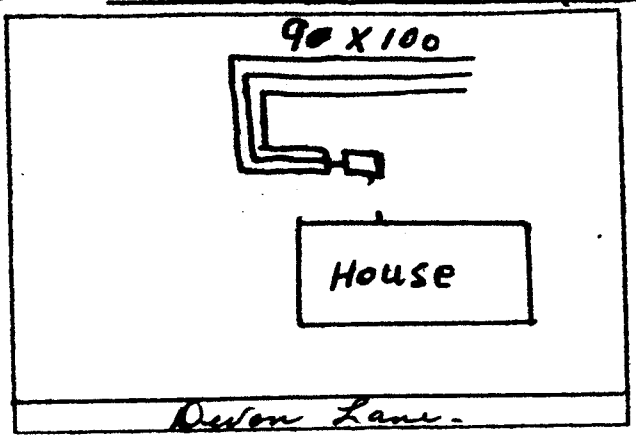

Sketch of Installation

E. A. Stevenson

Sanitarian