IREDELL COUNTY HEALTH DEPARTMENT

Statesville Phone TR 3-7271 Mooresville Phone No. 664-5281

PERMIT TO INSTALL SEPTIC TANK

Permit No. 216 Permit Date 5-7 1923

Owner Hope Bros. Bldr. Inc. Address Statesville, NC

Installed By Hope Bros. Address Statesville, NC


Location of Property IREDELL HEIGHTS -
Debbie LANE - #63 -
2nd HOUSE ON Rt. from END of STREET

Tank		Capacity		Length of Lines		Fixtures	
Block	( )	1000	(✓)	225'	( )	No. of Baths	(1½)
Precast	(✓)	1250	( )	250'	( )	Dishwasher	( )
		1500	( )	Other 300		Garbage Grdr.	( )
		Other		900 Sq Ft.		Other	

NOTIFY HEALTH DEPARTMENT AT LEAST EIGHT HOURS BEFORE TANK IS TO BE INSPECTED.

Final Inspection 5-7 1923 Approved (✓) Disapproved ( )

Remarks Statesville Water Co.

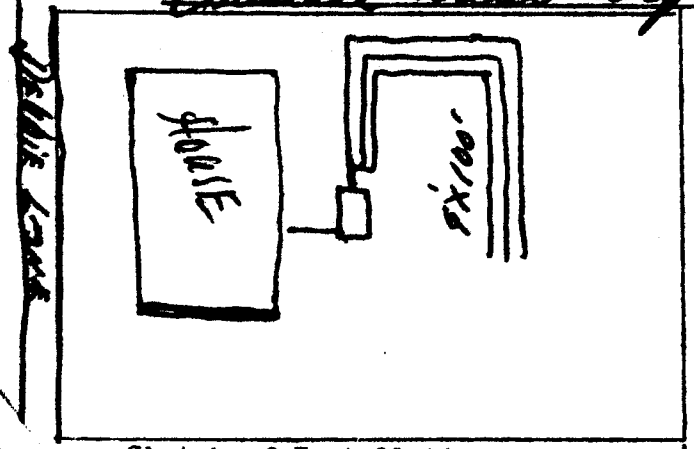

Sketch of Installation

Sanitarian